
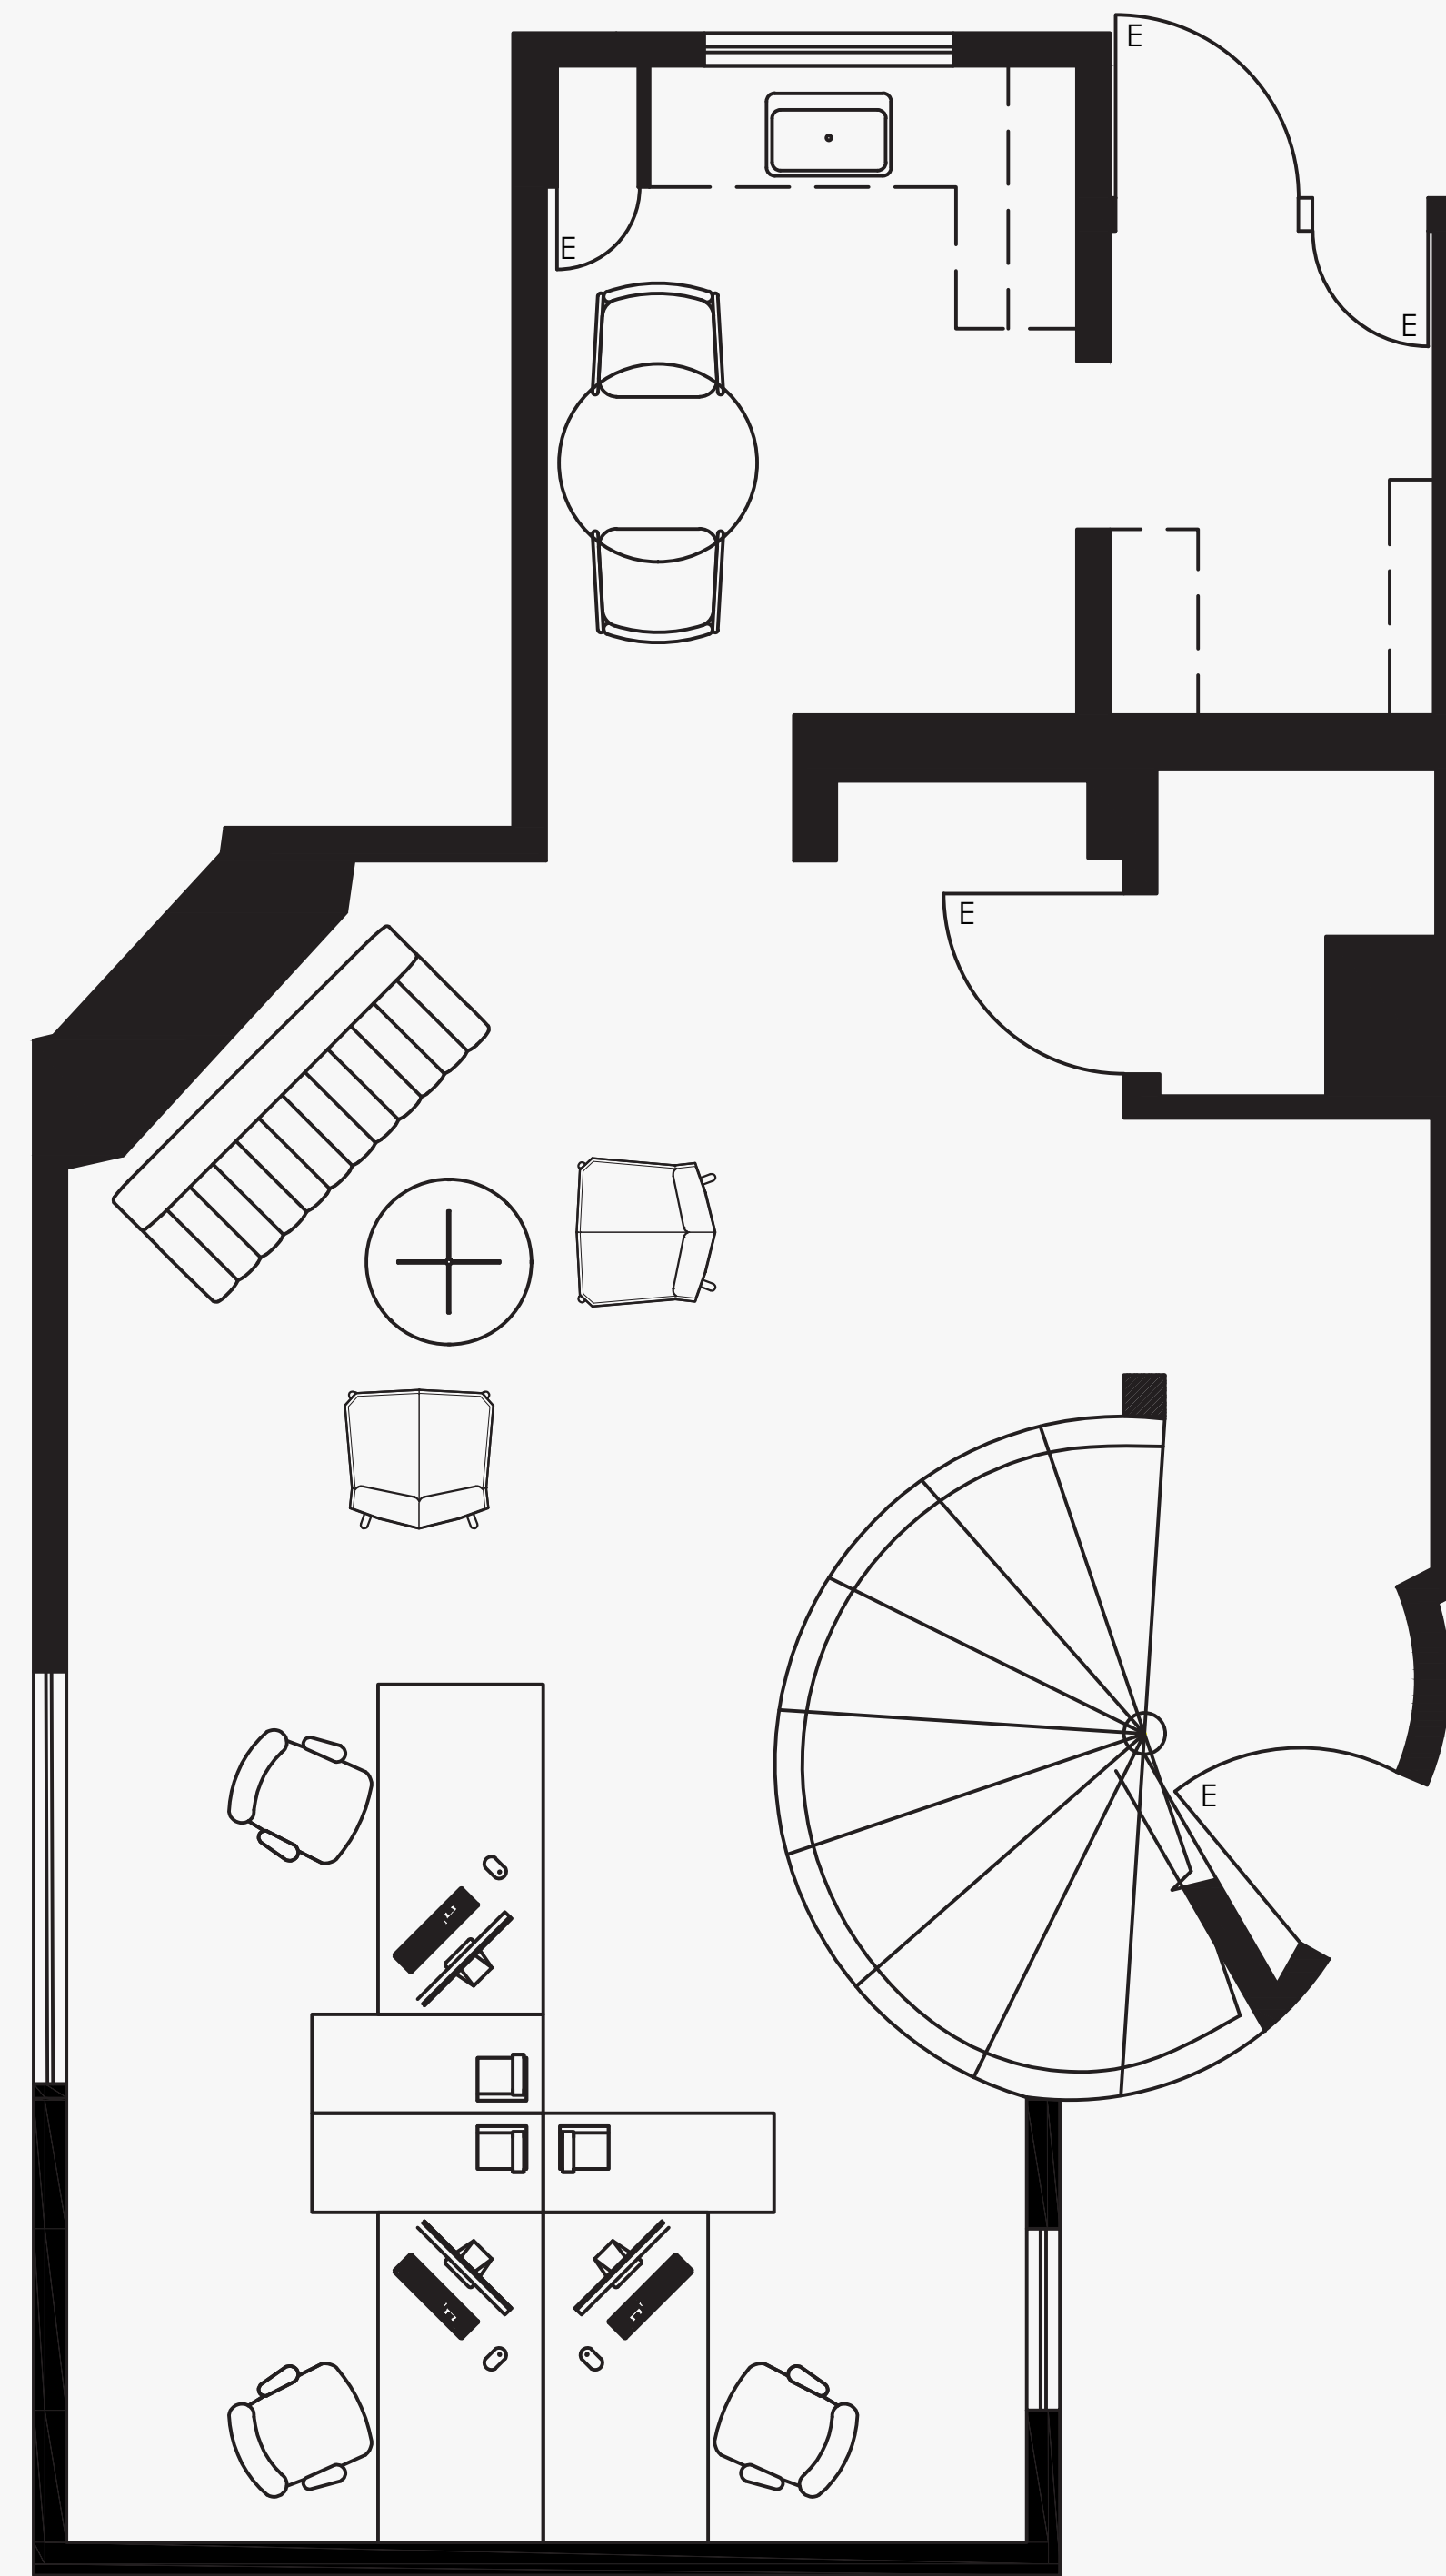



## AS-BUILT CONFIGURATION

- OFFICES..... 2
- KITCHEN..... 1
- OPEN WORK AREA..... +/- 3

## KEY PLAN (FURNITURE AND APPLIANCES NOT INCLUDED)

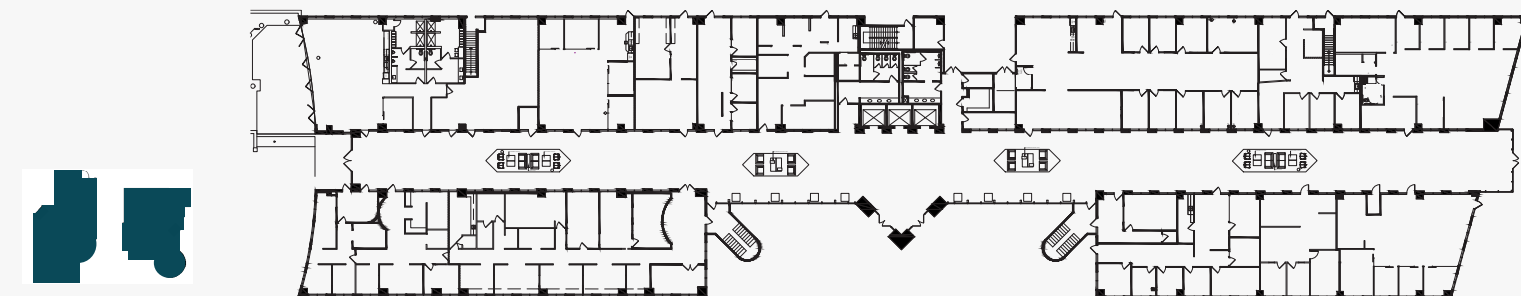

### LOWER LEVEL

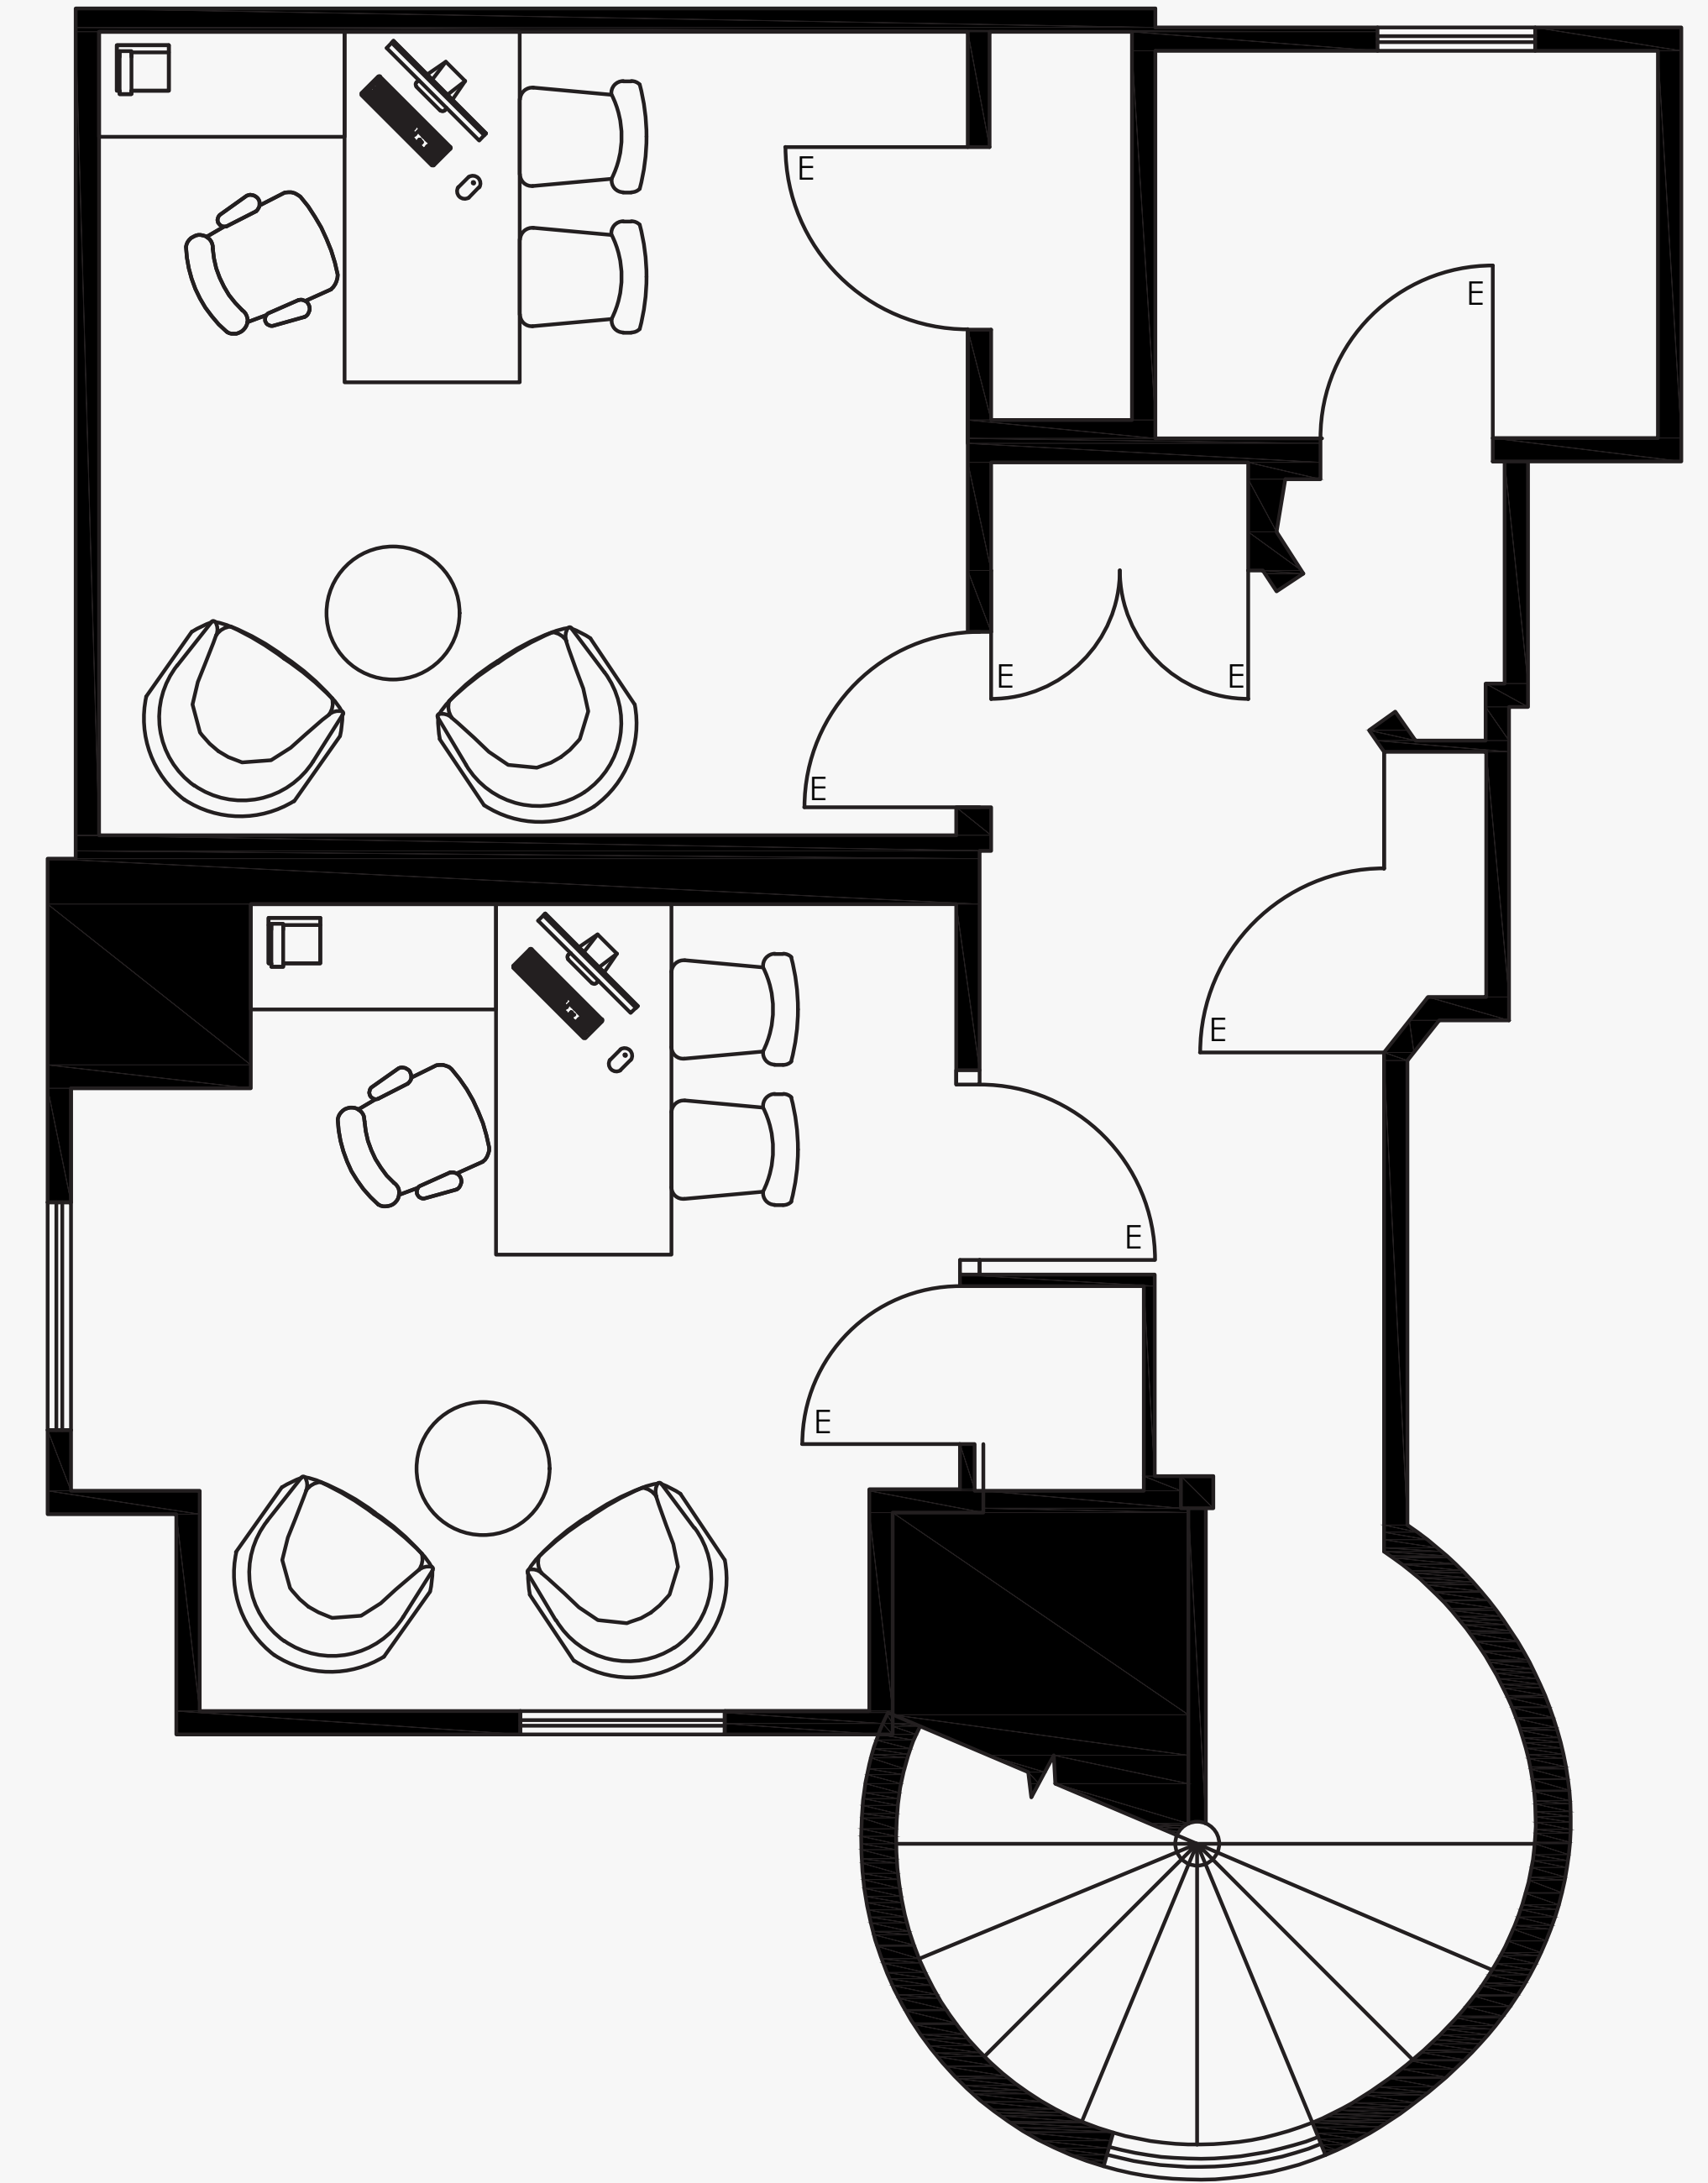

### UPPER LEVEL