

# COTTAGE 10675A

RSF: 1,383




## AS-BUILT CONFIGURATION


- OFFICES..... 2
- KITCHEN..... 1
- OPEN WORK AREA..... +/- 3

### KEY PLAN

*Not to scale, furniture and appliances not included*

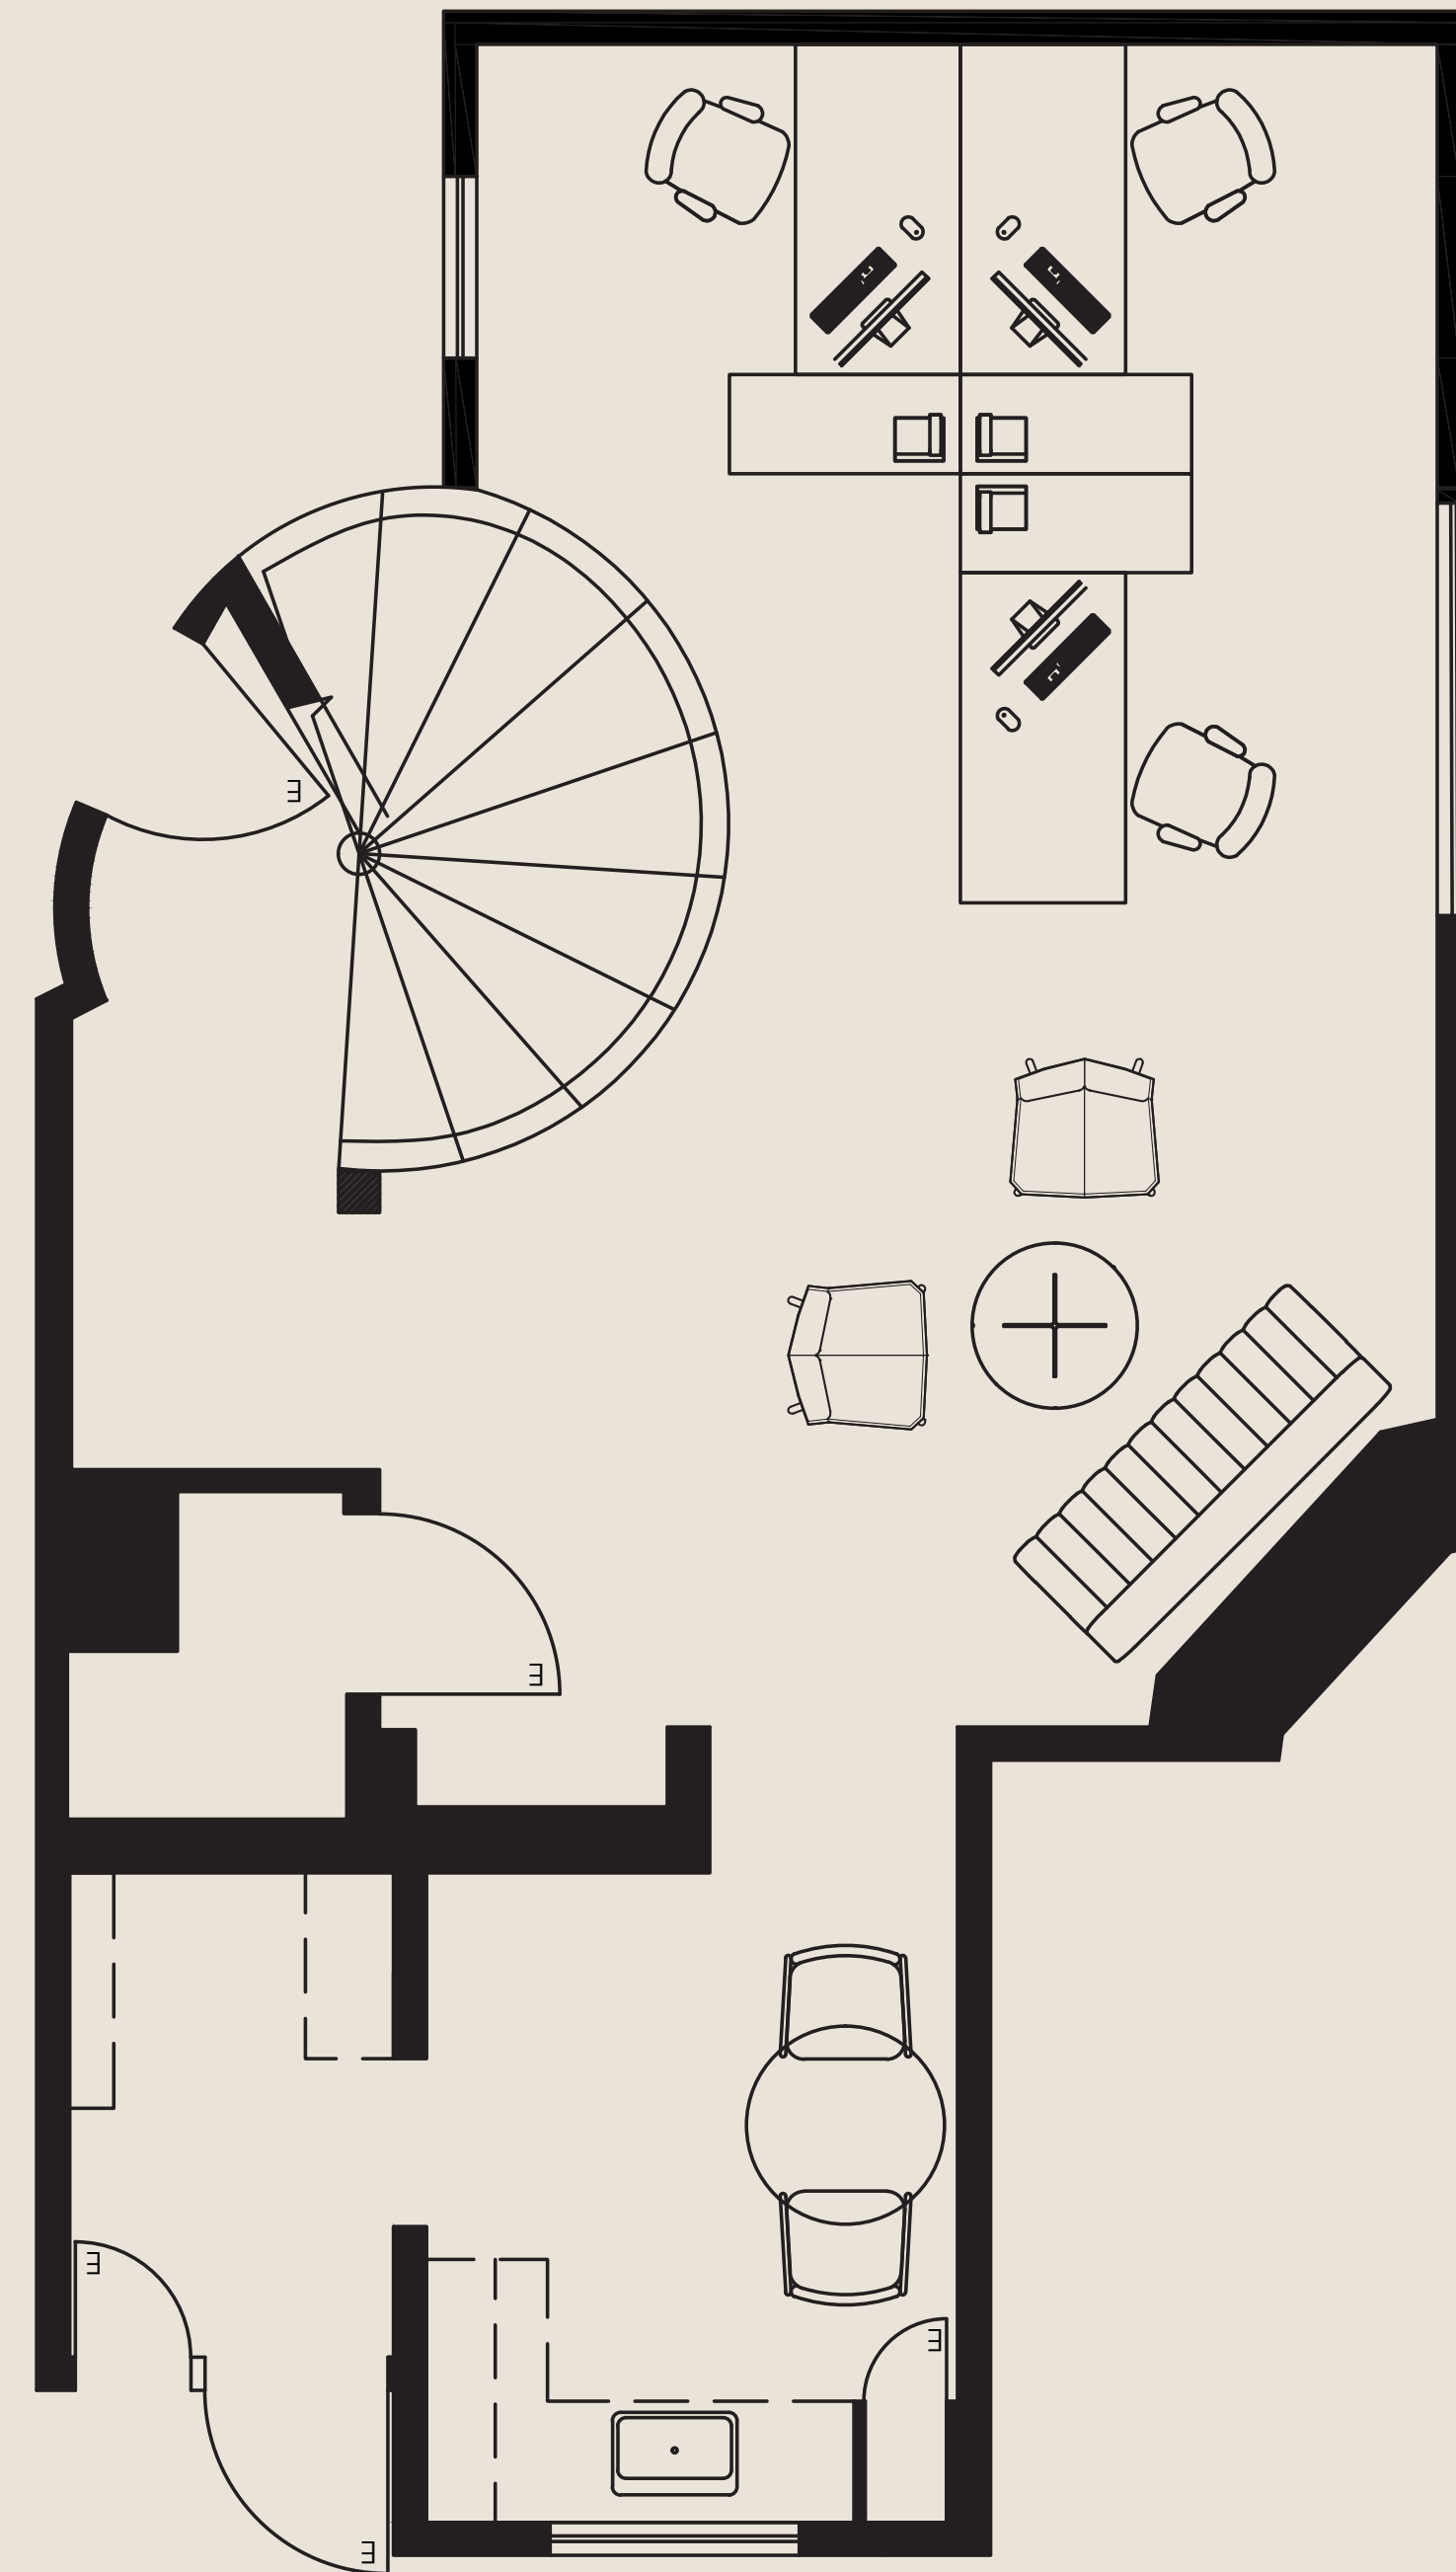

LOWER LEVEL

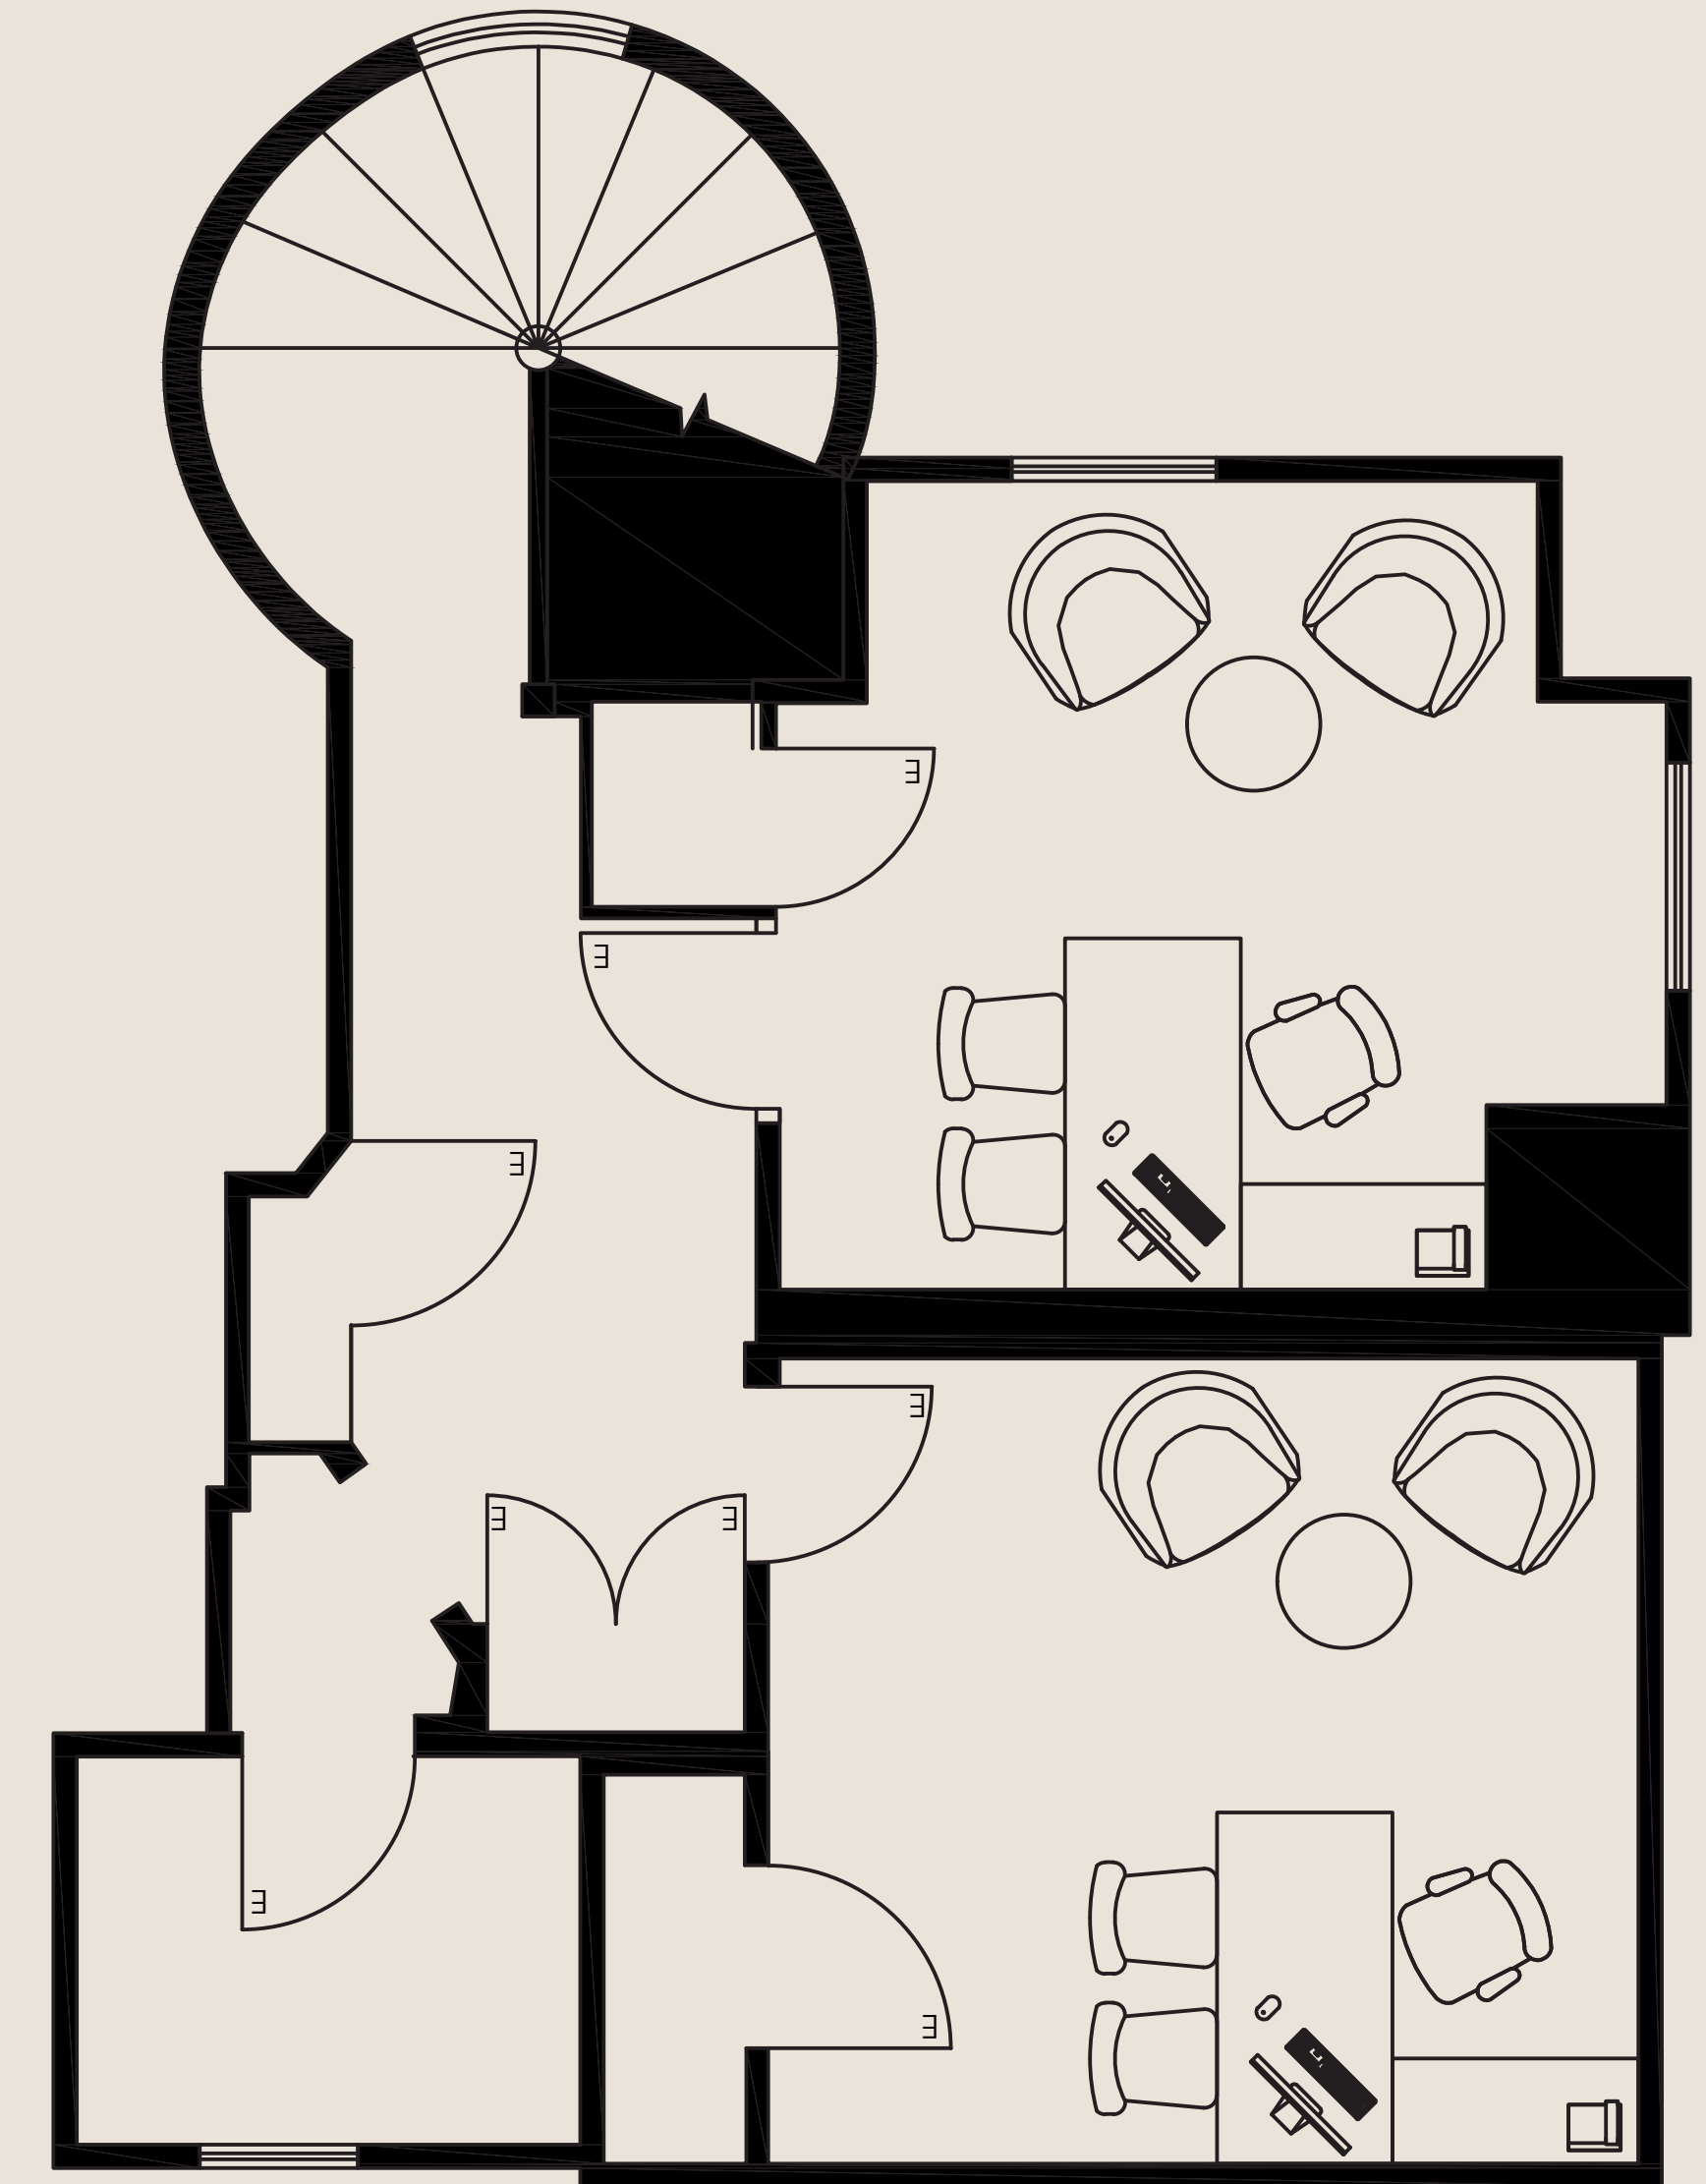

UPPER LEVEL

For leasing information please contact:  
USALEASING@ONNI.COM  
(213) 629-2041

