

COTTAGE 10681

RSF: 1,363





AS-BUILT CONFIGURATION


OFFICES.....	2
KITCHEN.....	1
OPEN WORK AREA.....	1
BATHROOM.....	1

KEY PLAN

Not to scale, furniture and appliances not included

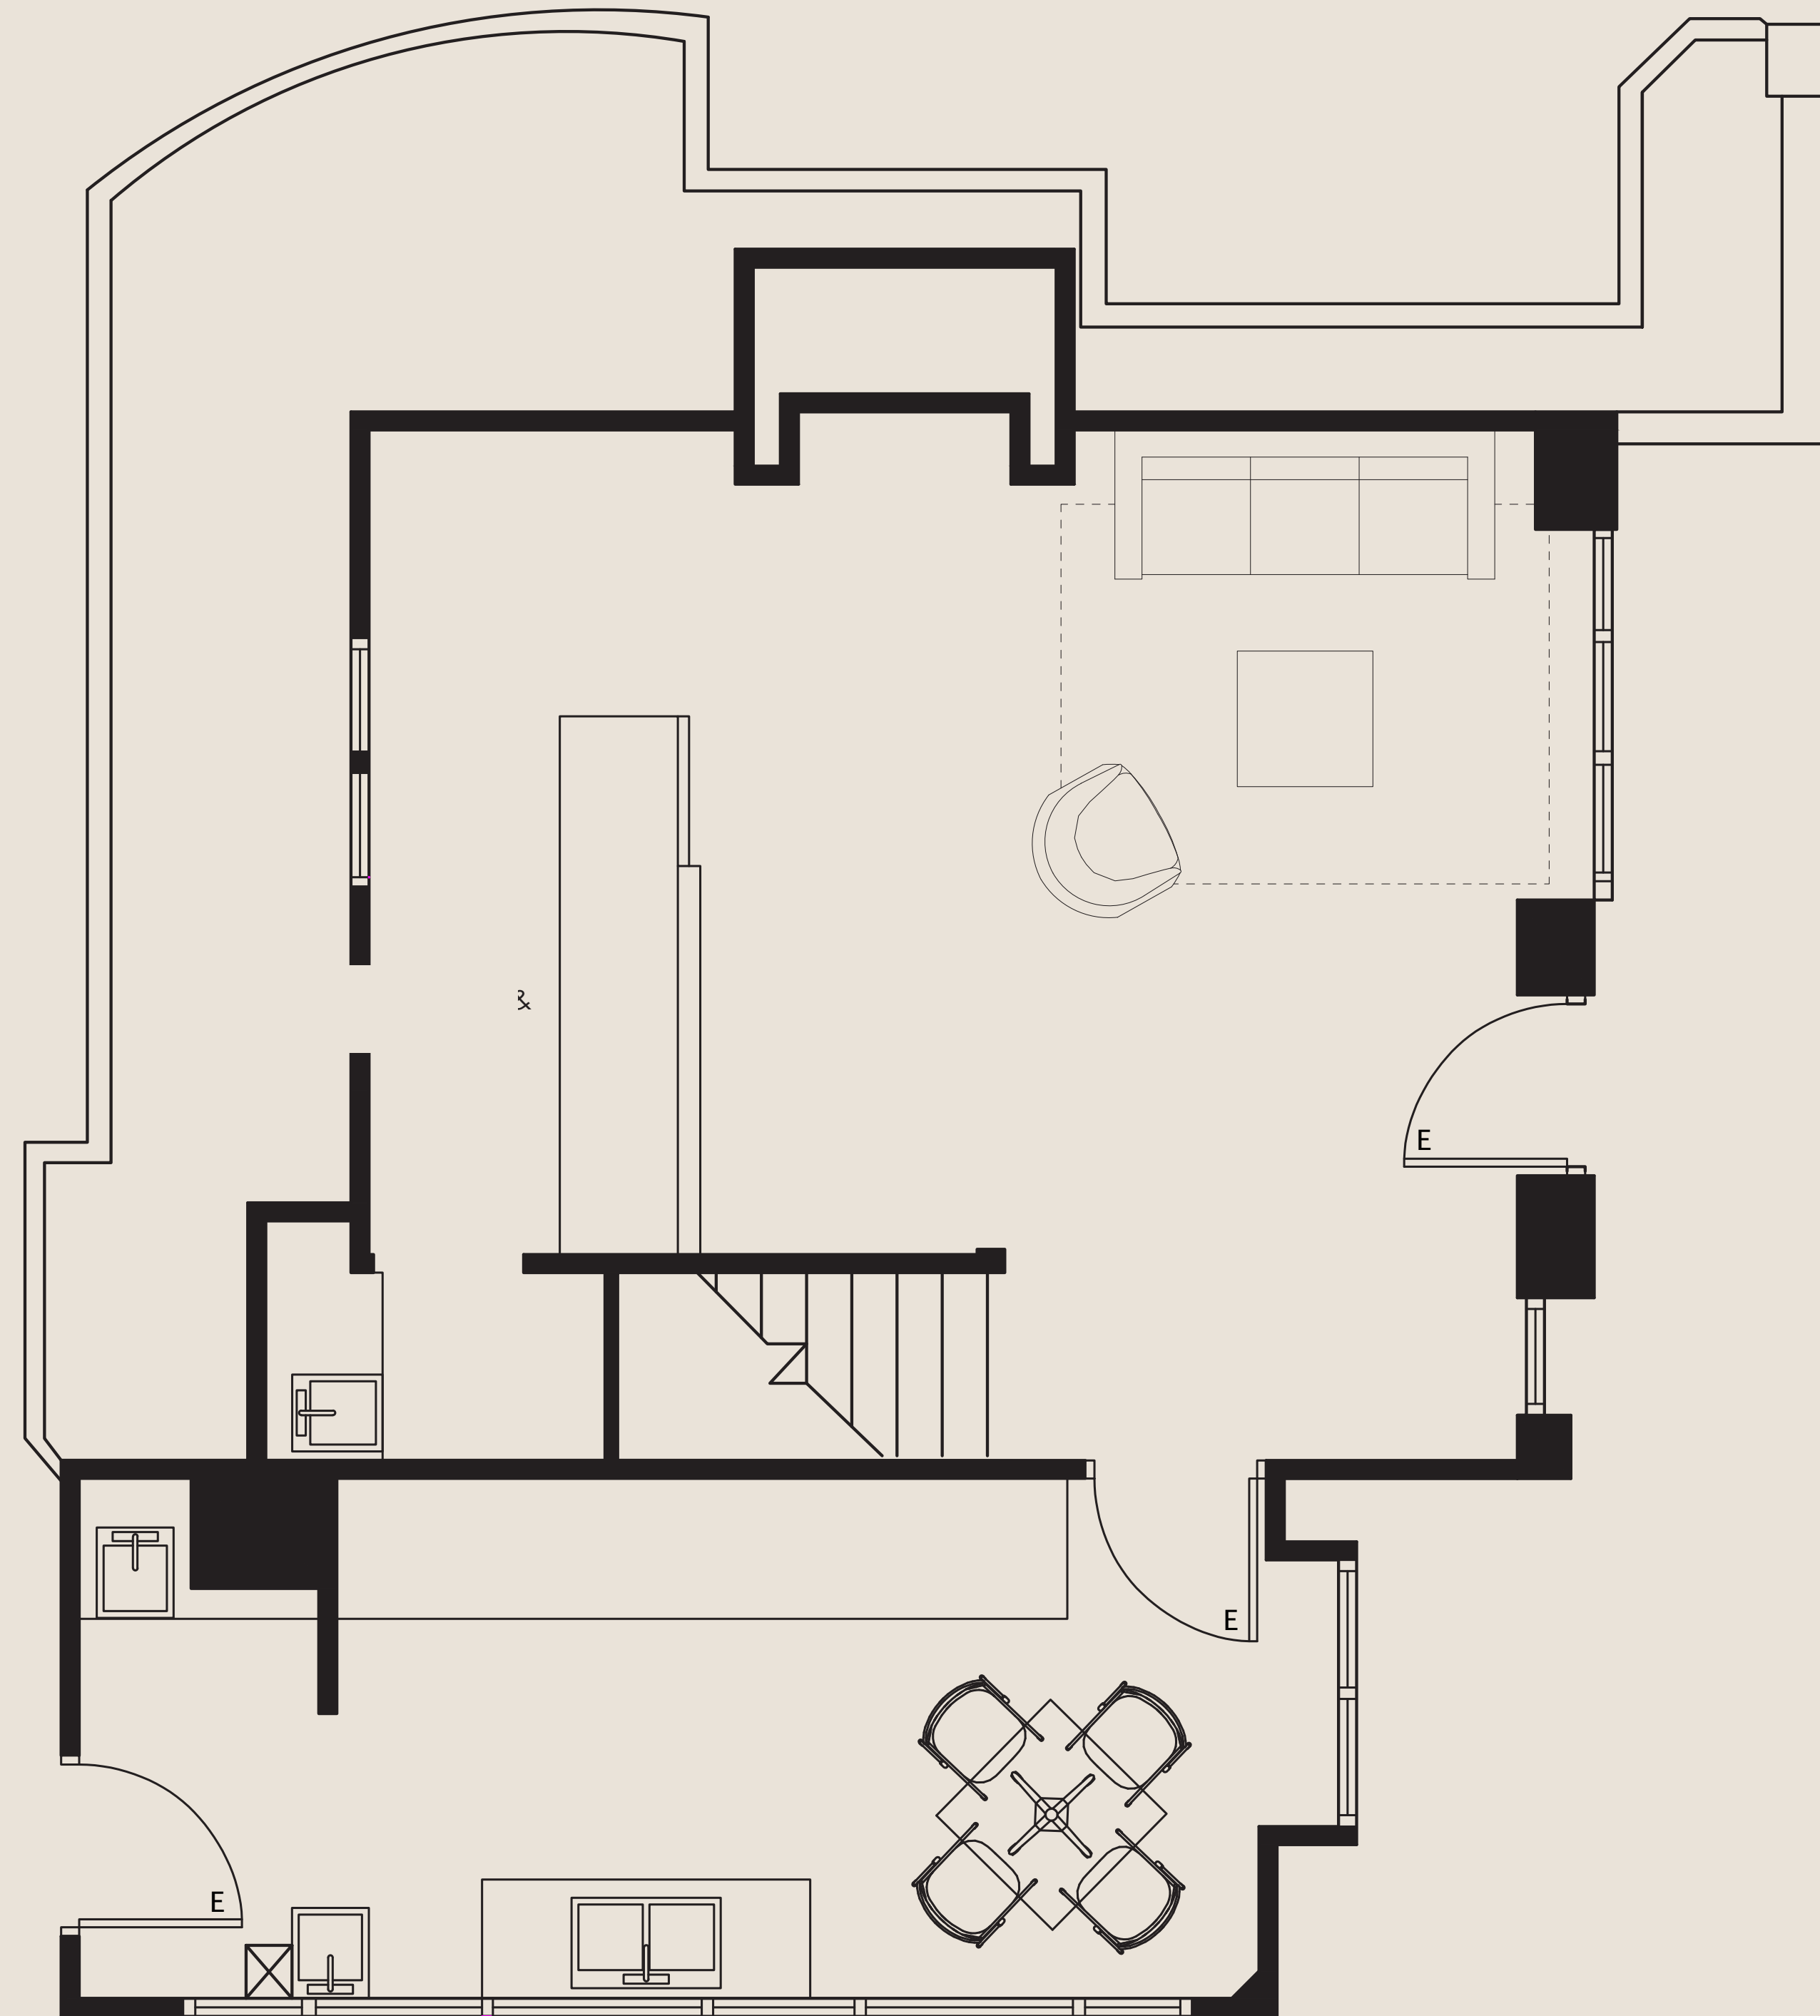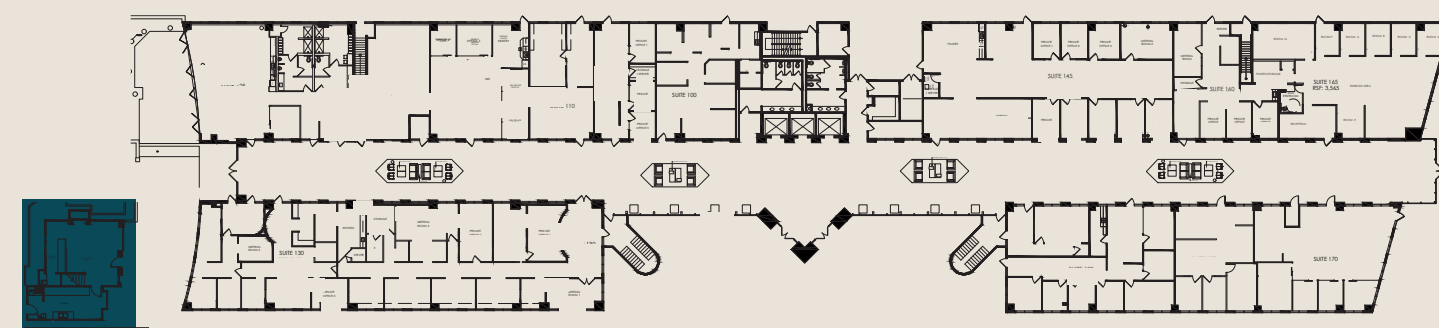

LOWER LEVEL

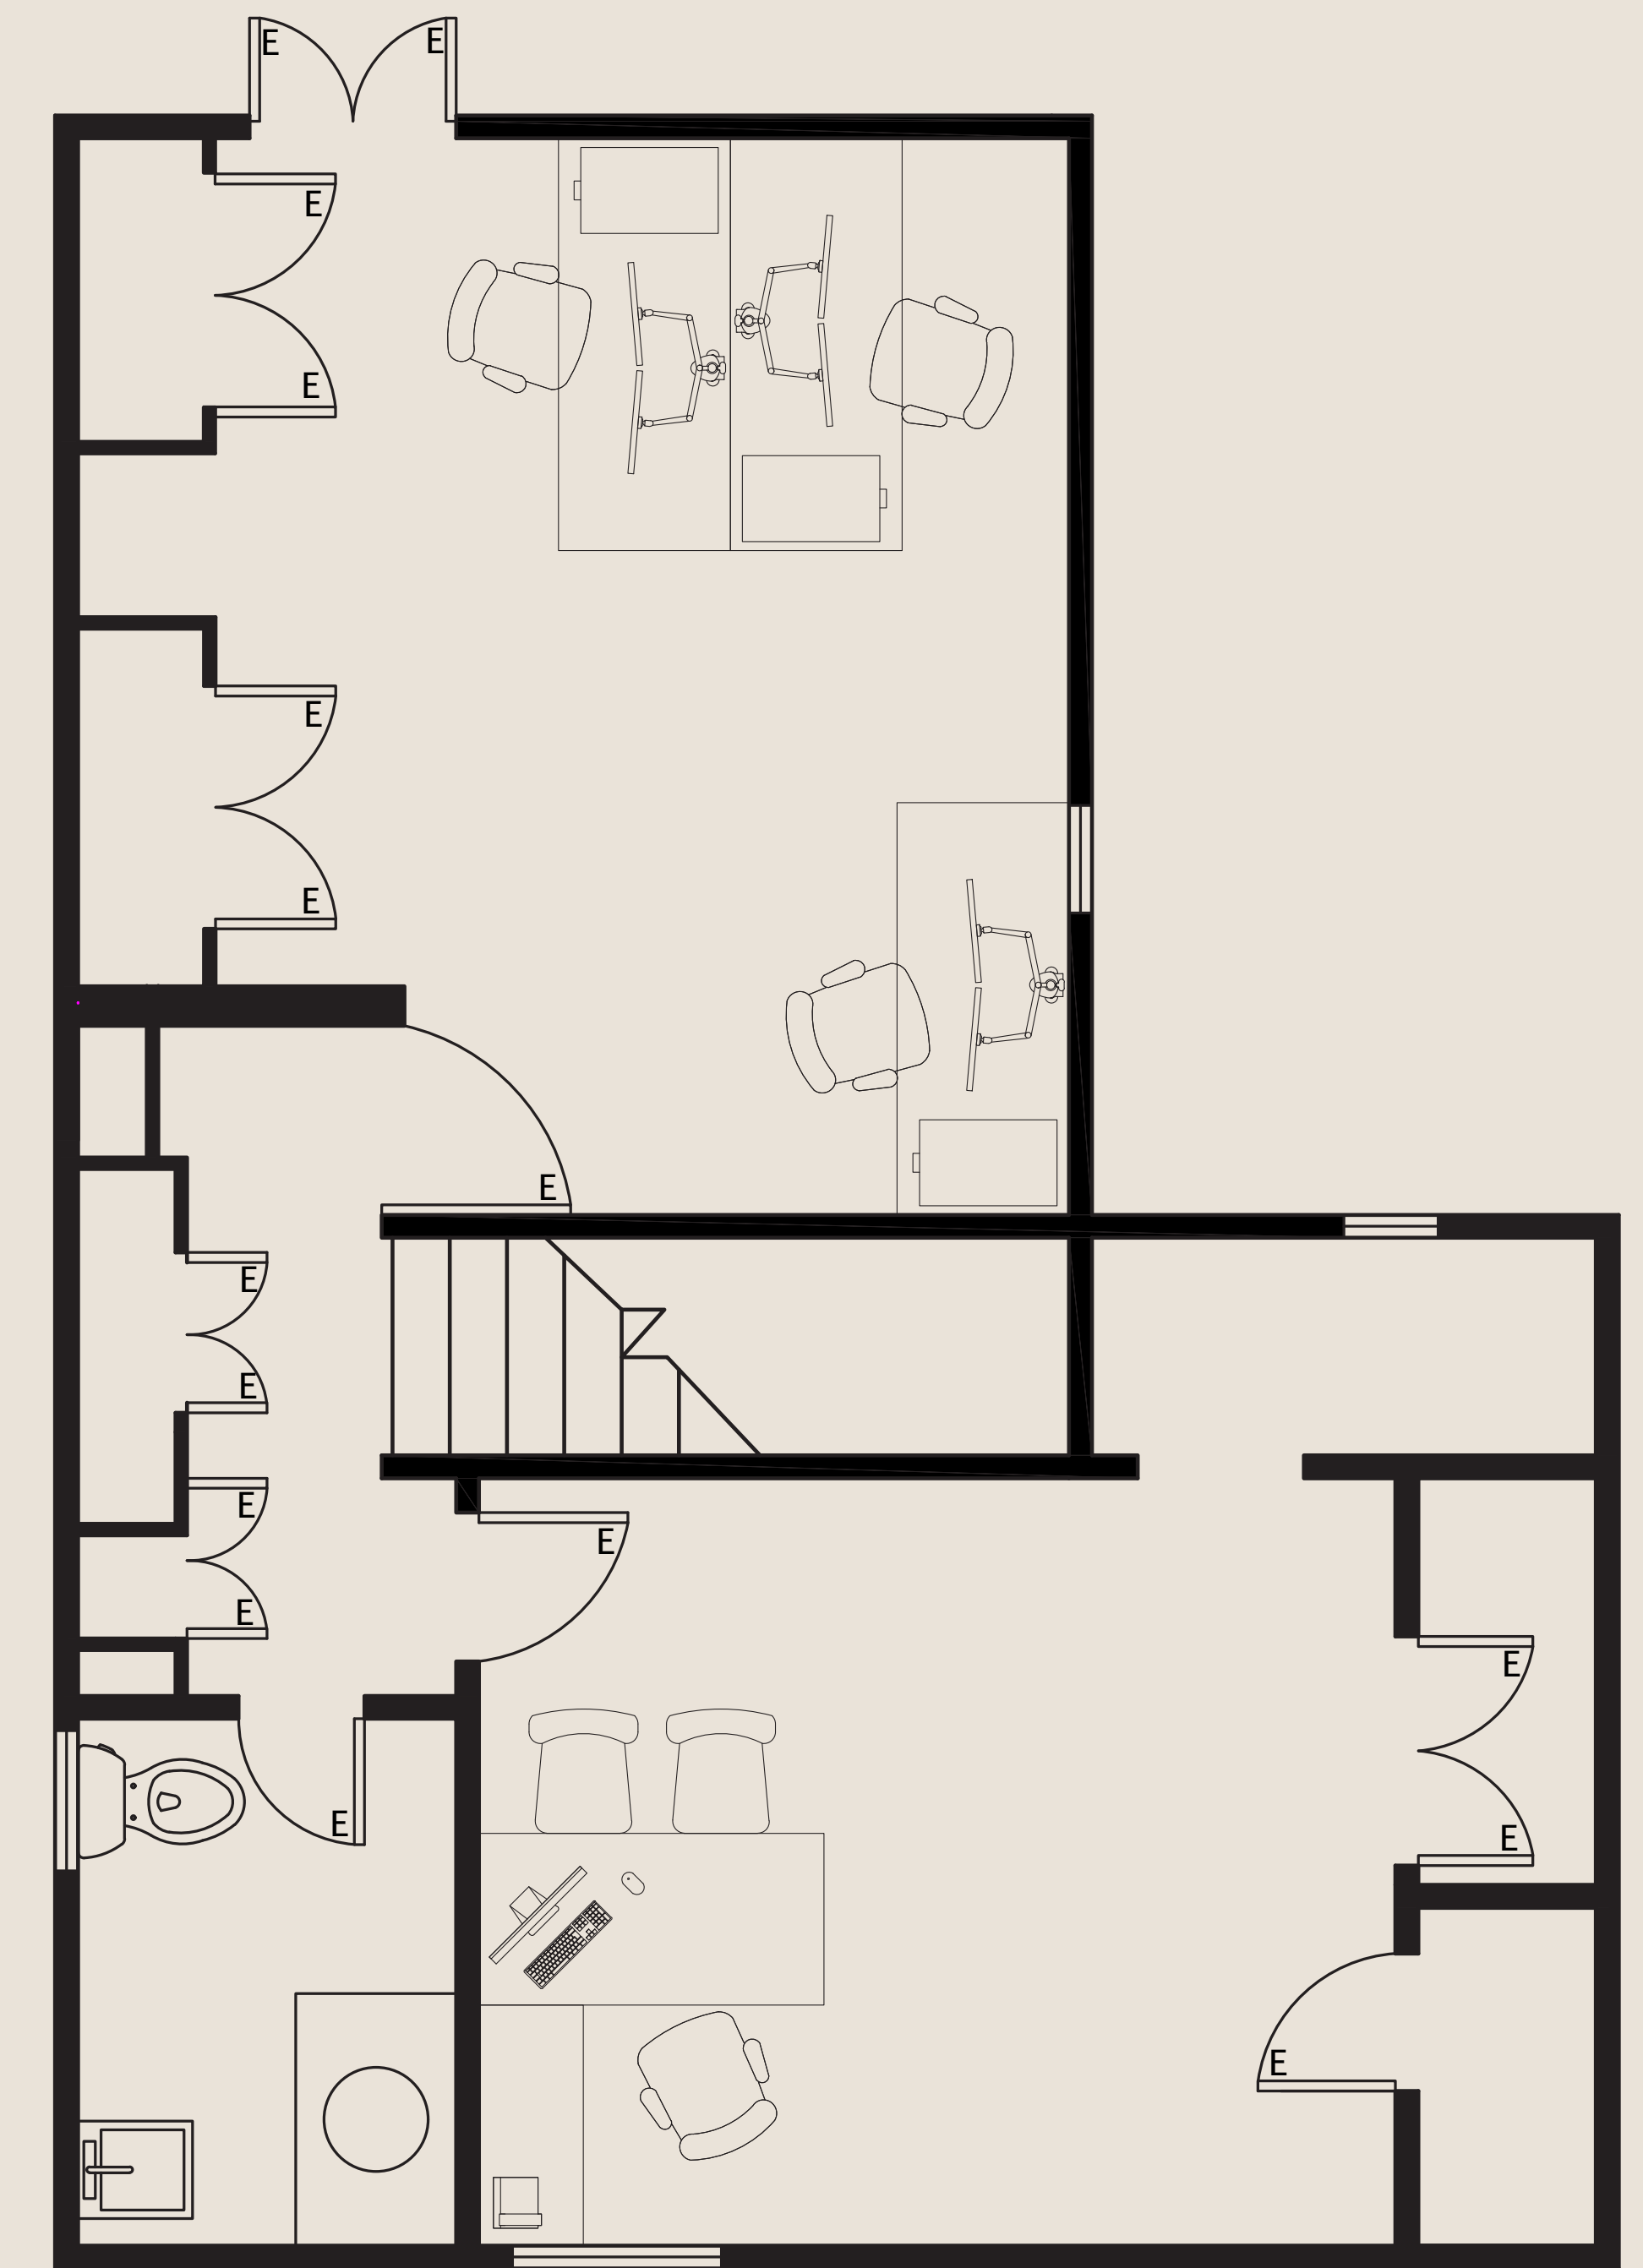

UPPER LEVEL

For leasing information please contact:
USALEASING@ONNI.COM
(213) 629-2041

