
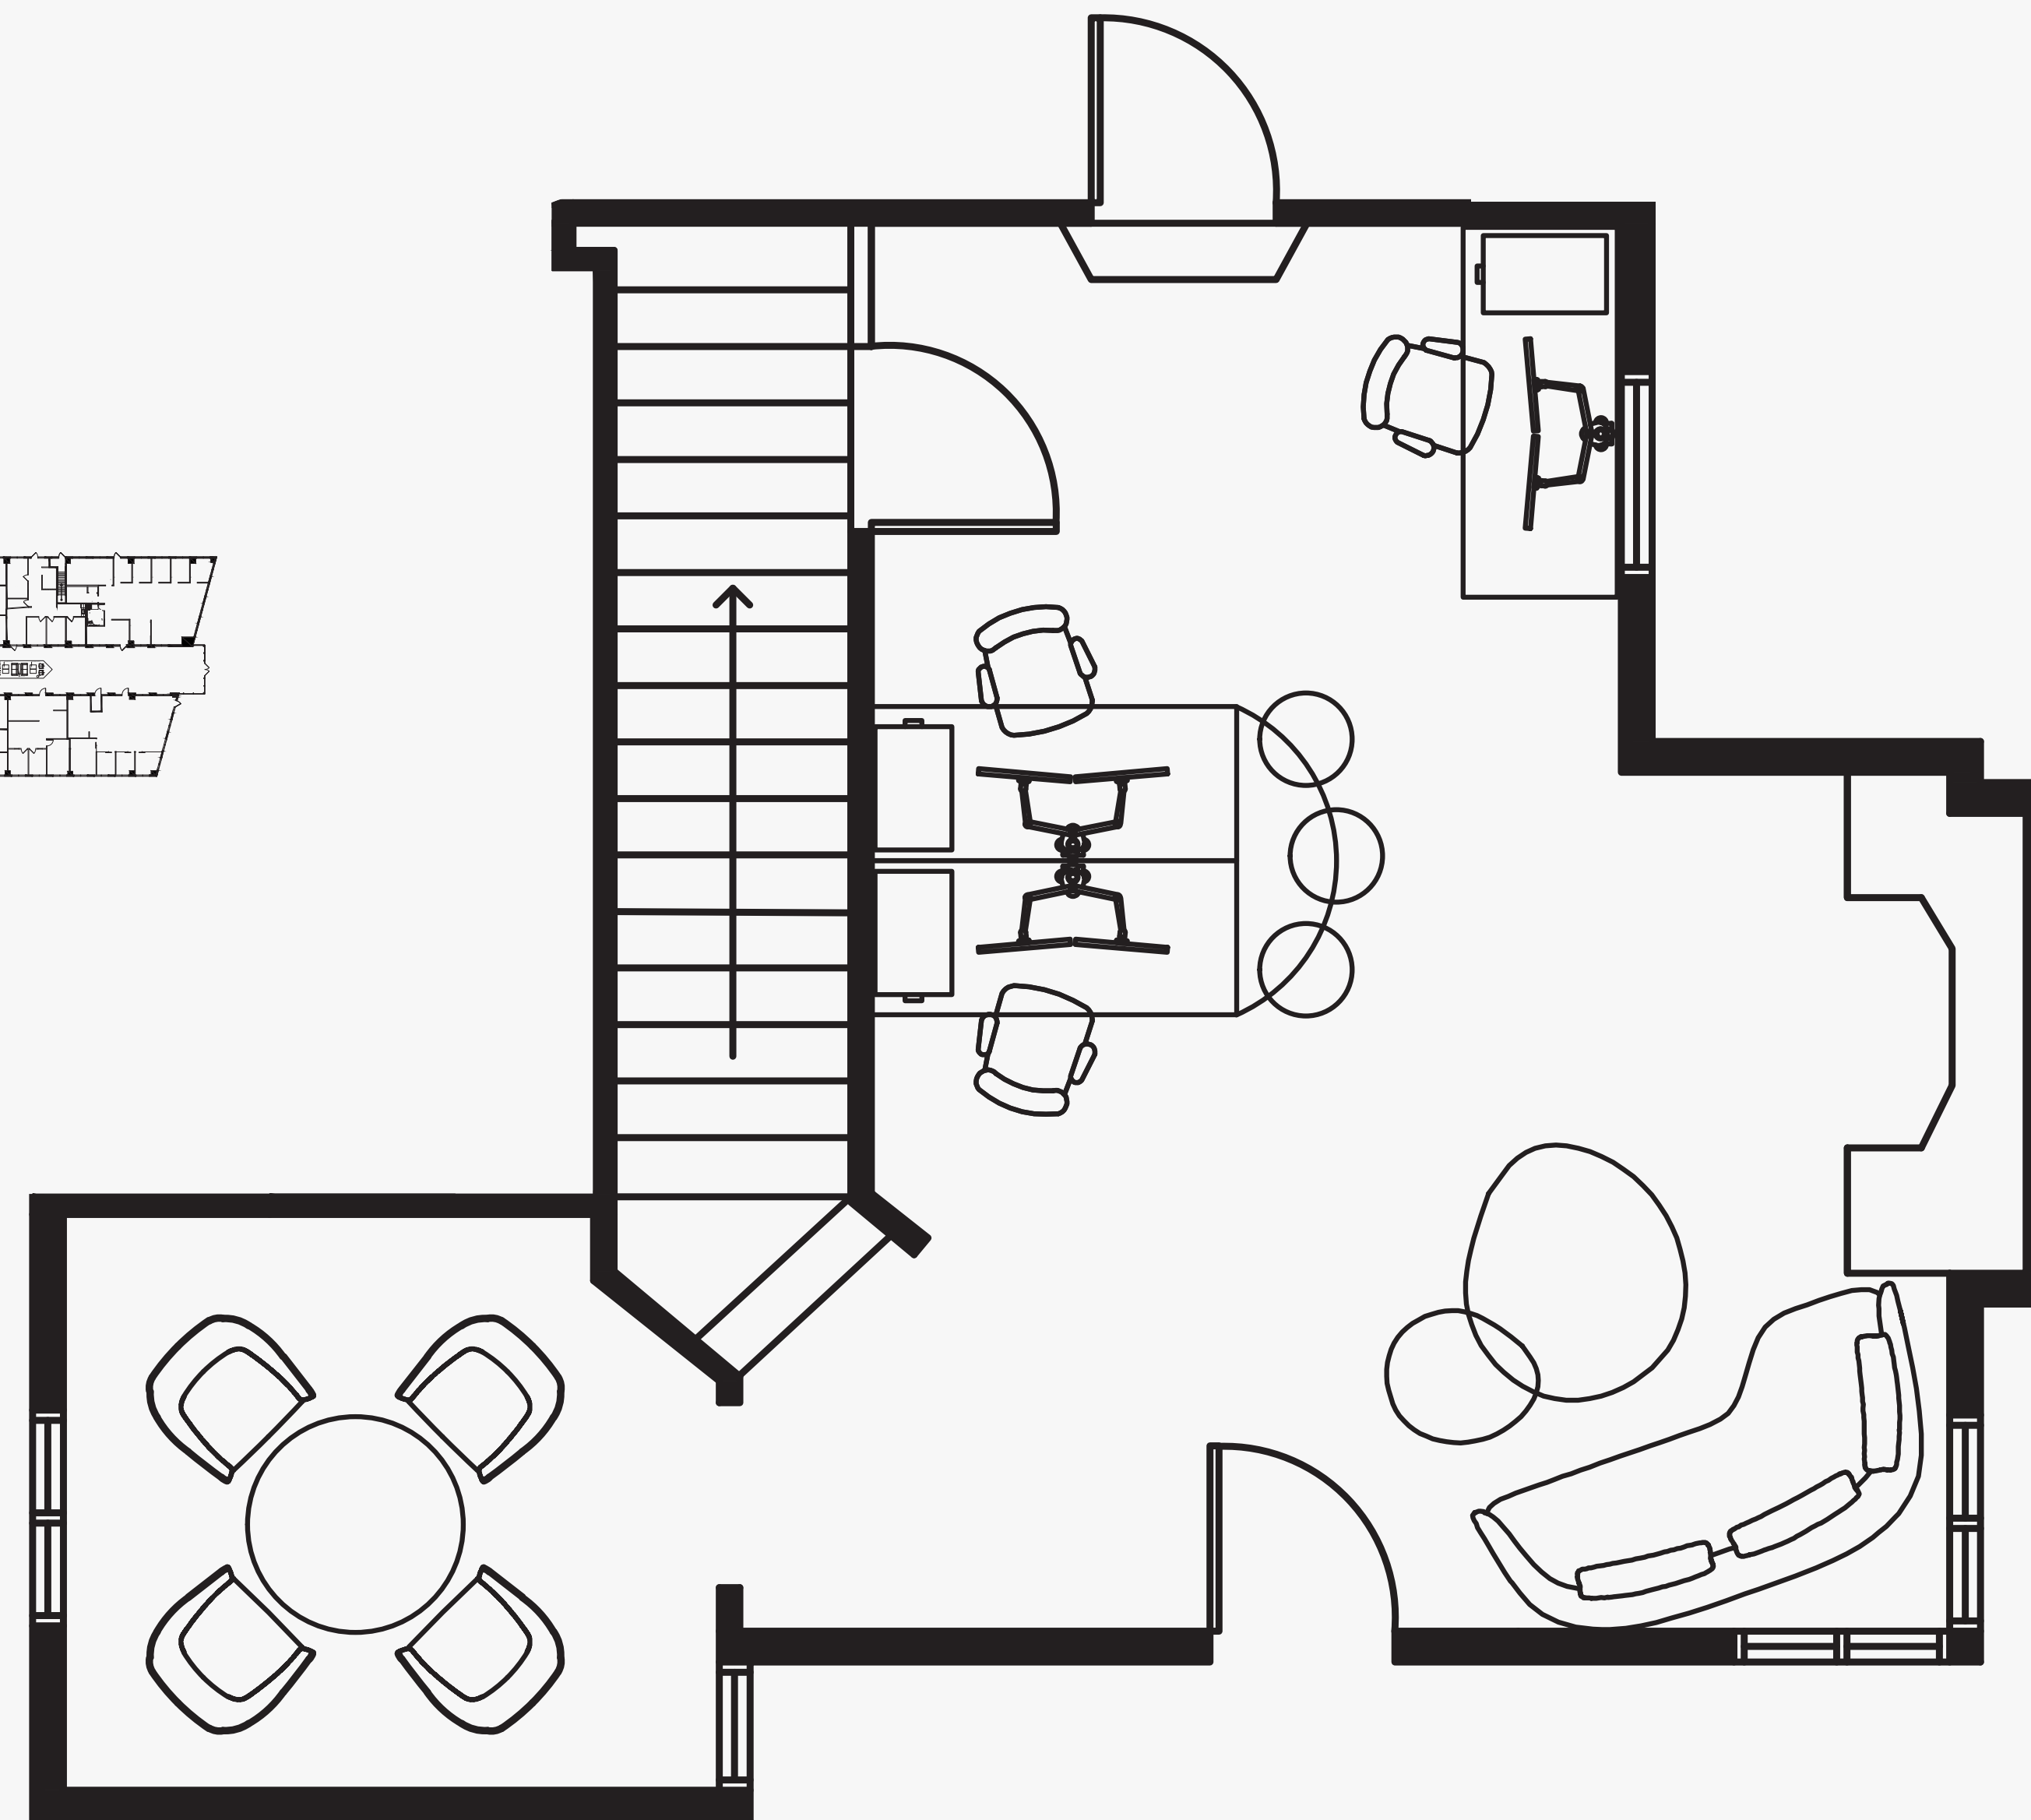


AS-BUILT CONFIGURATION


PRIVATE OFFICES.....1

OPEN WORK AREA.....+/-3

KEY PLAN
(FURNITURE AND APPLIANCES NOT INCLUDED)

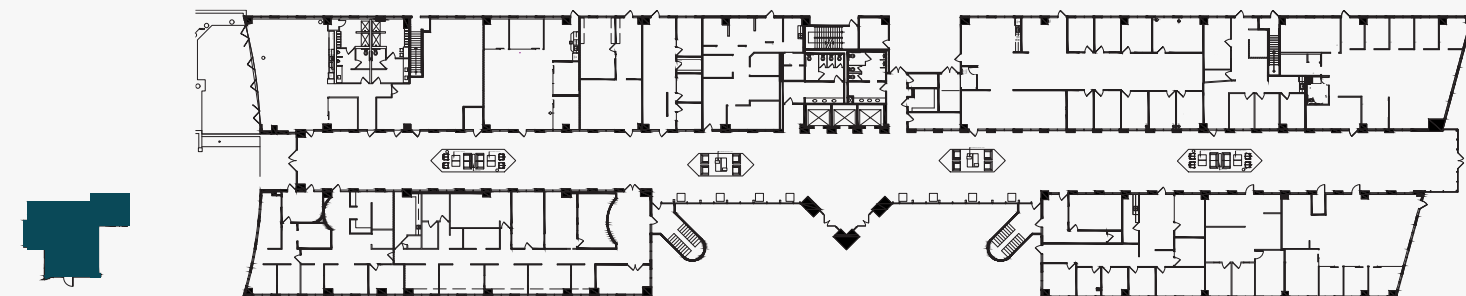

LOWER LEVEL

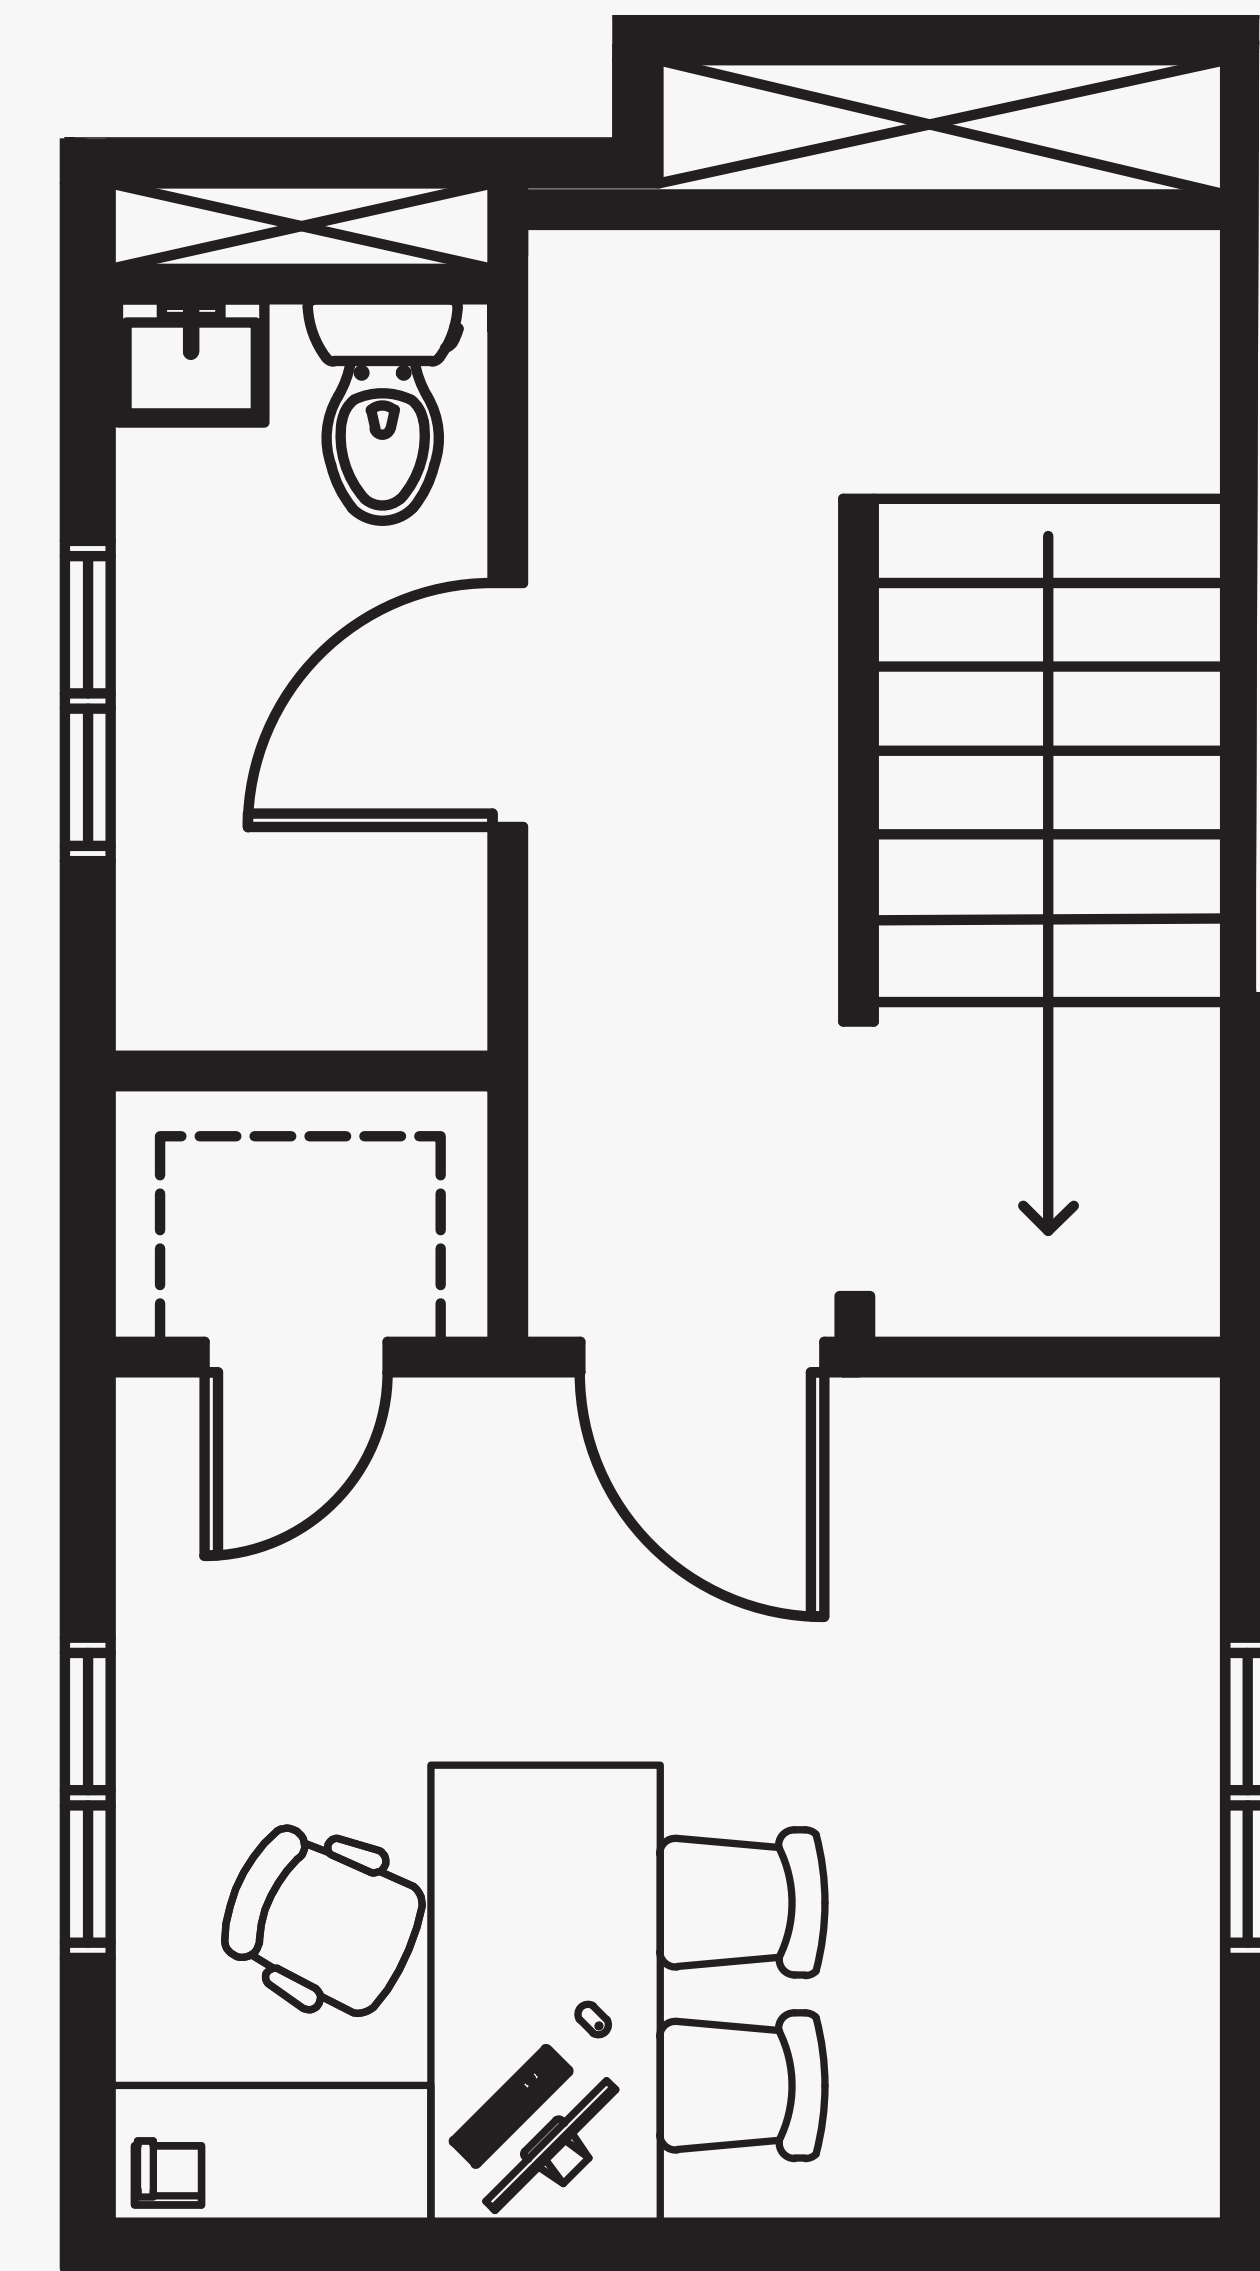

UPPER LEVEL