


AS-BUILT CONFIGURATION

PRIVATE OFFICES.....1


OPEN WORK AREA.....+/-3

KEY PLAN

(FURNITURE AND APPLIANCES NOT INCLUDED)

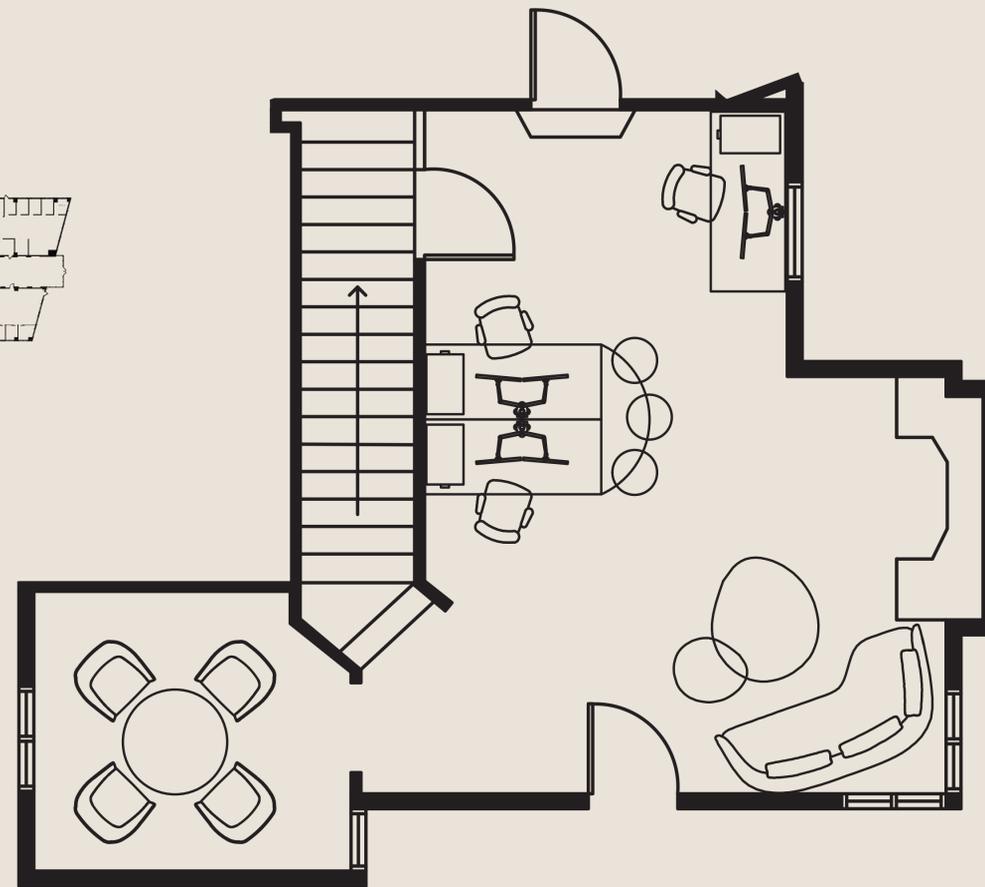

LOWER LEVEL

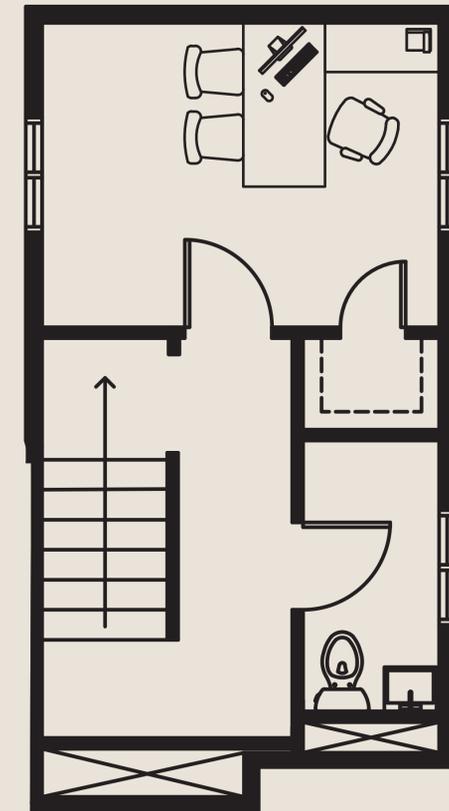

UPPER LEVEL