

# COTTAGE 10685

RSF: 1,638



## AS-BUILT CONFIGURATION


OFFICES..... N/A

KITCHEN..... N/A


OPEN WORK AREA..... N/A

### KEY PLAN

*Not to scale, furniture and appliances not included*

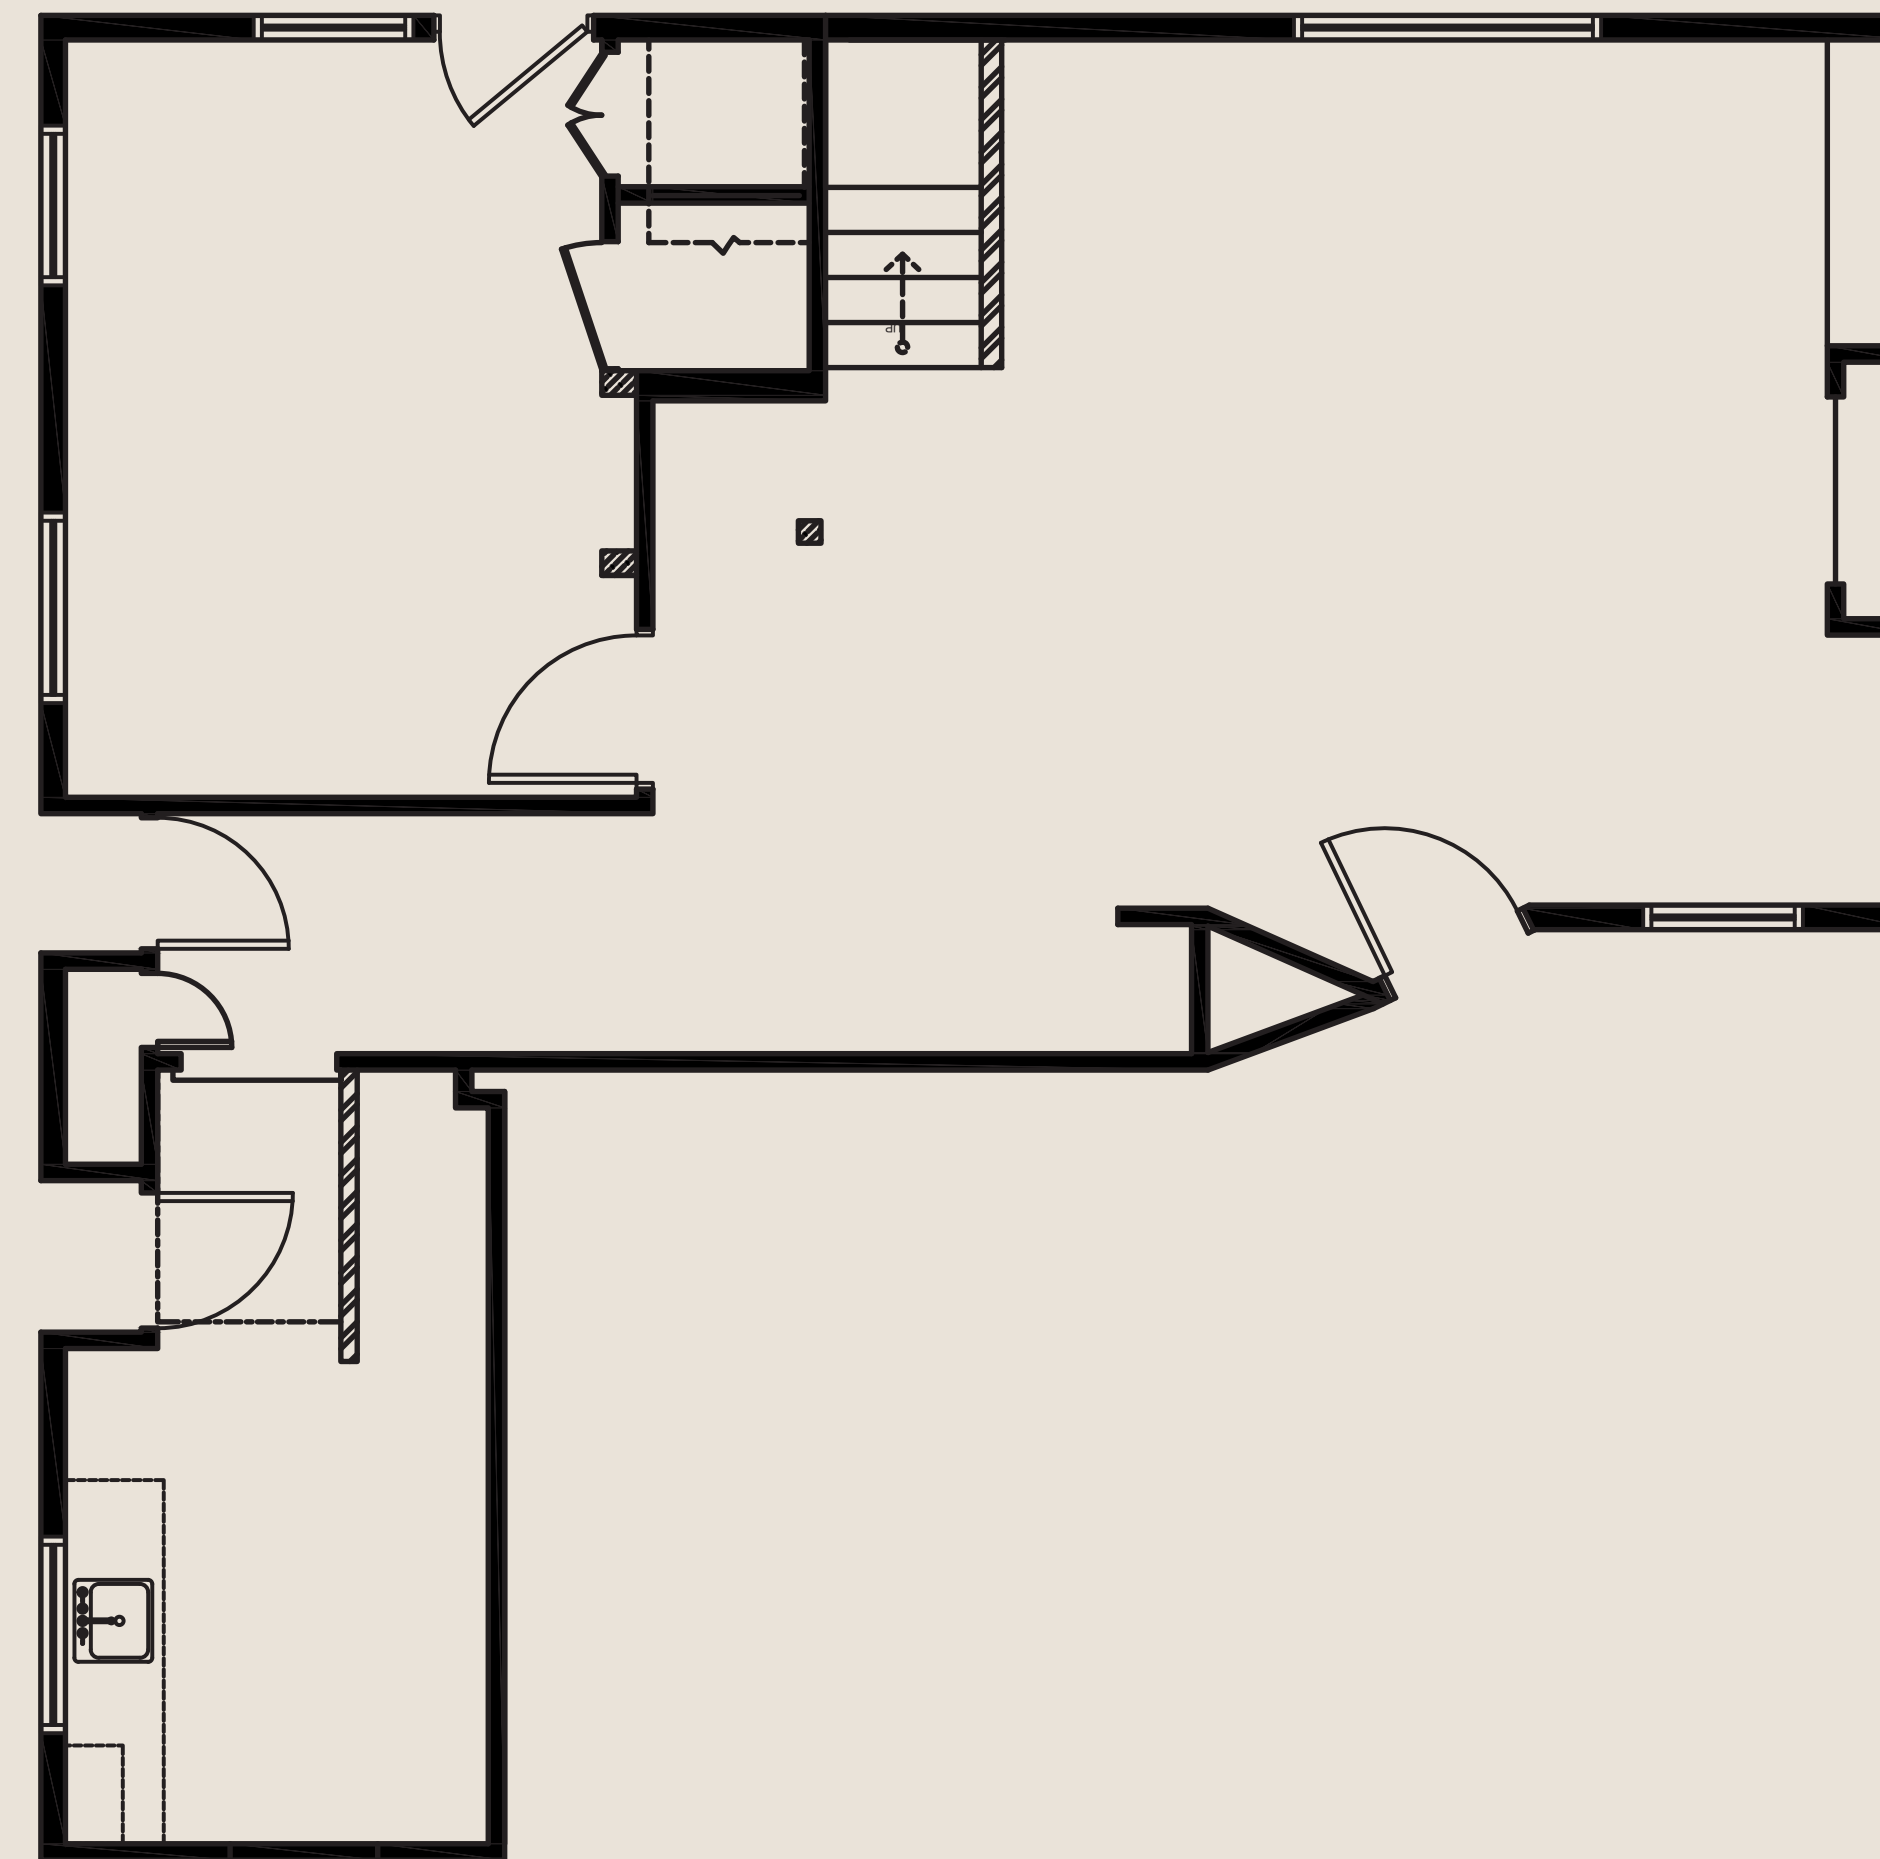

LOWER LEVEL

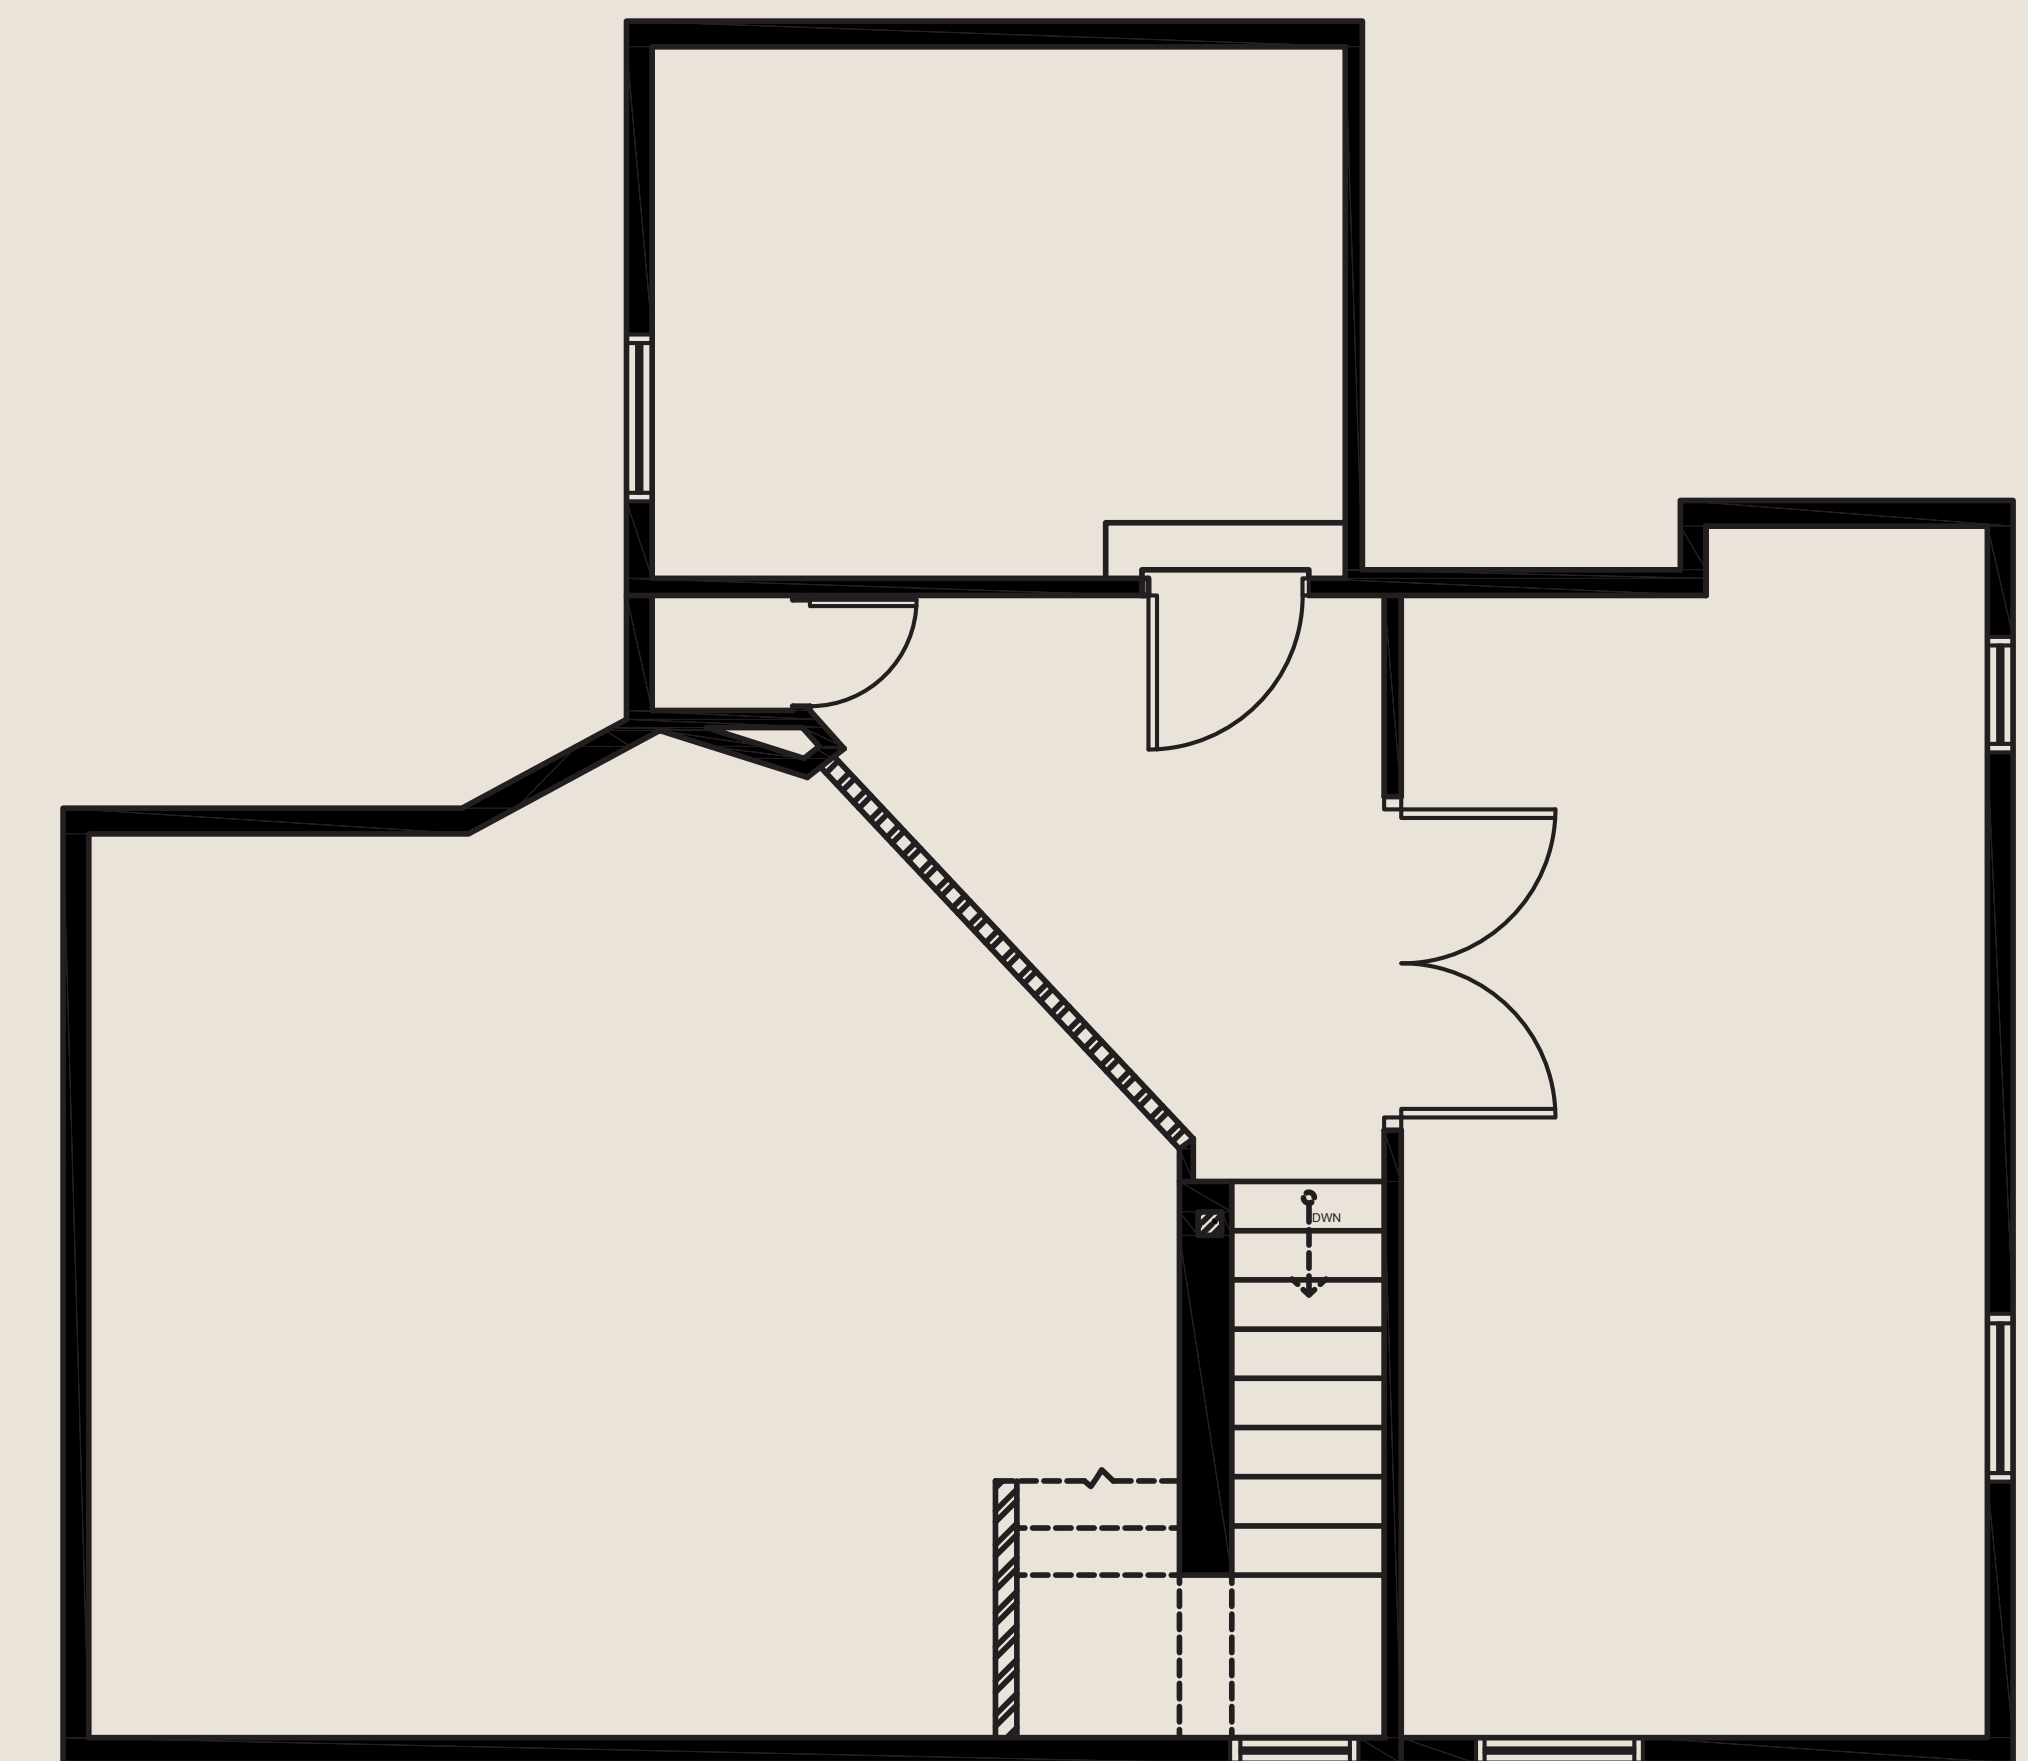

UPPER LEVEL

For leasing information please contact:  
USALEASING@ONNI.COM  
(213) 629-2041

