
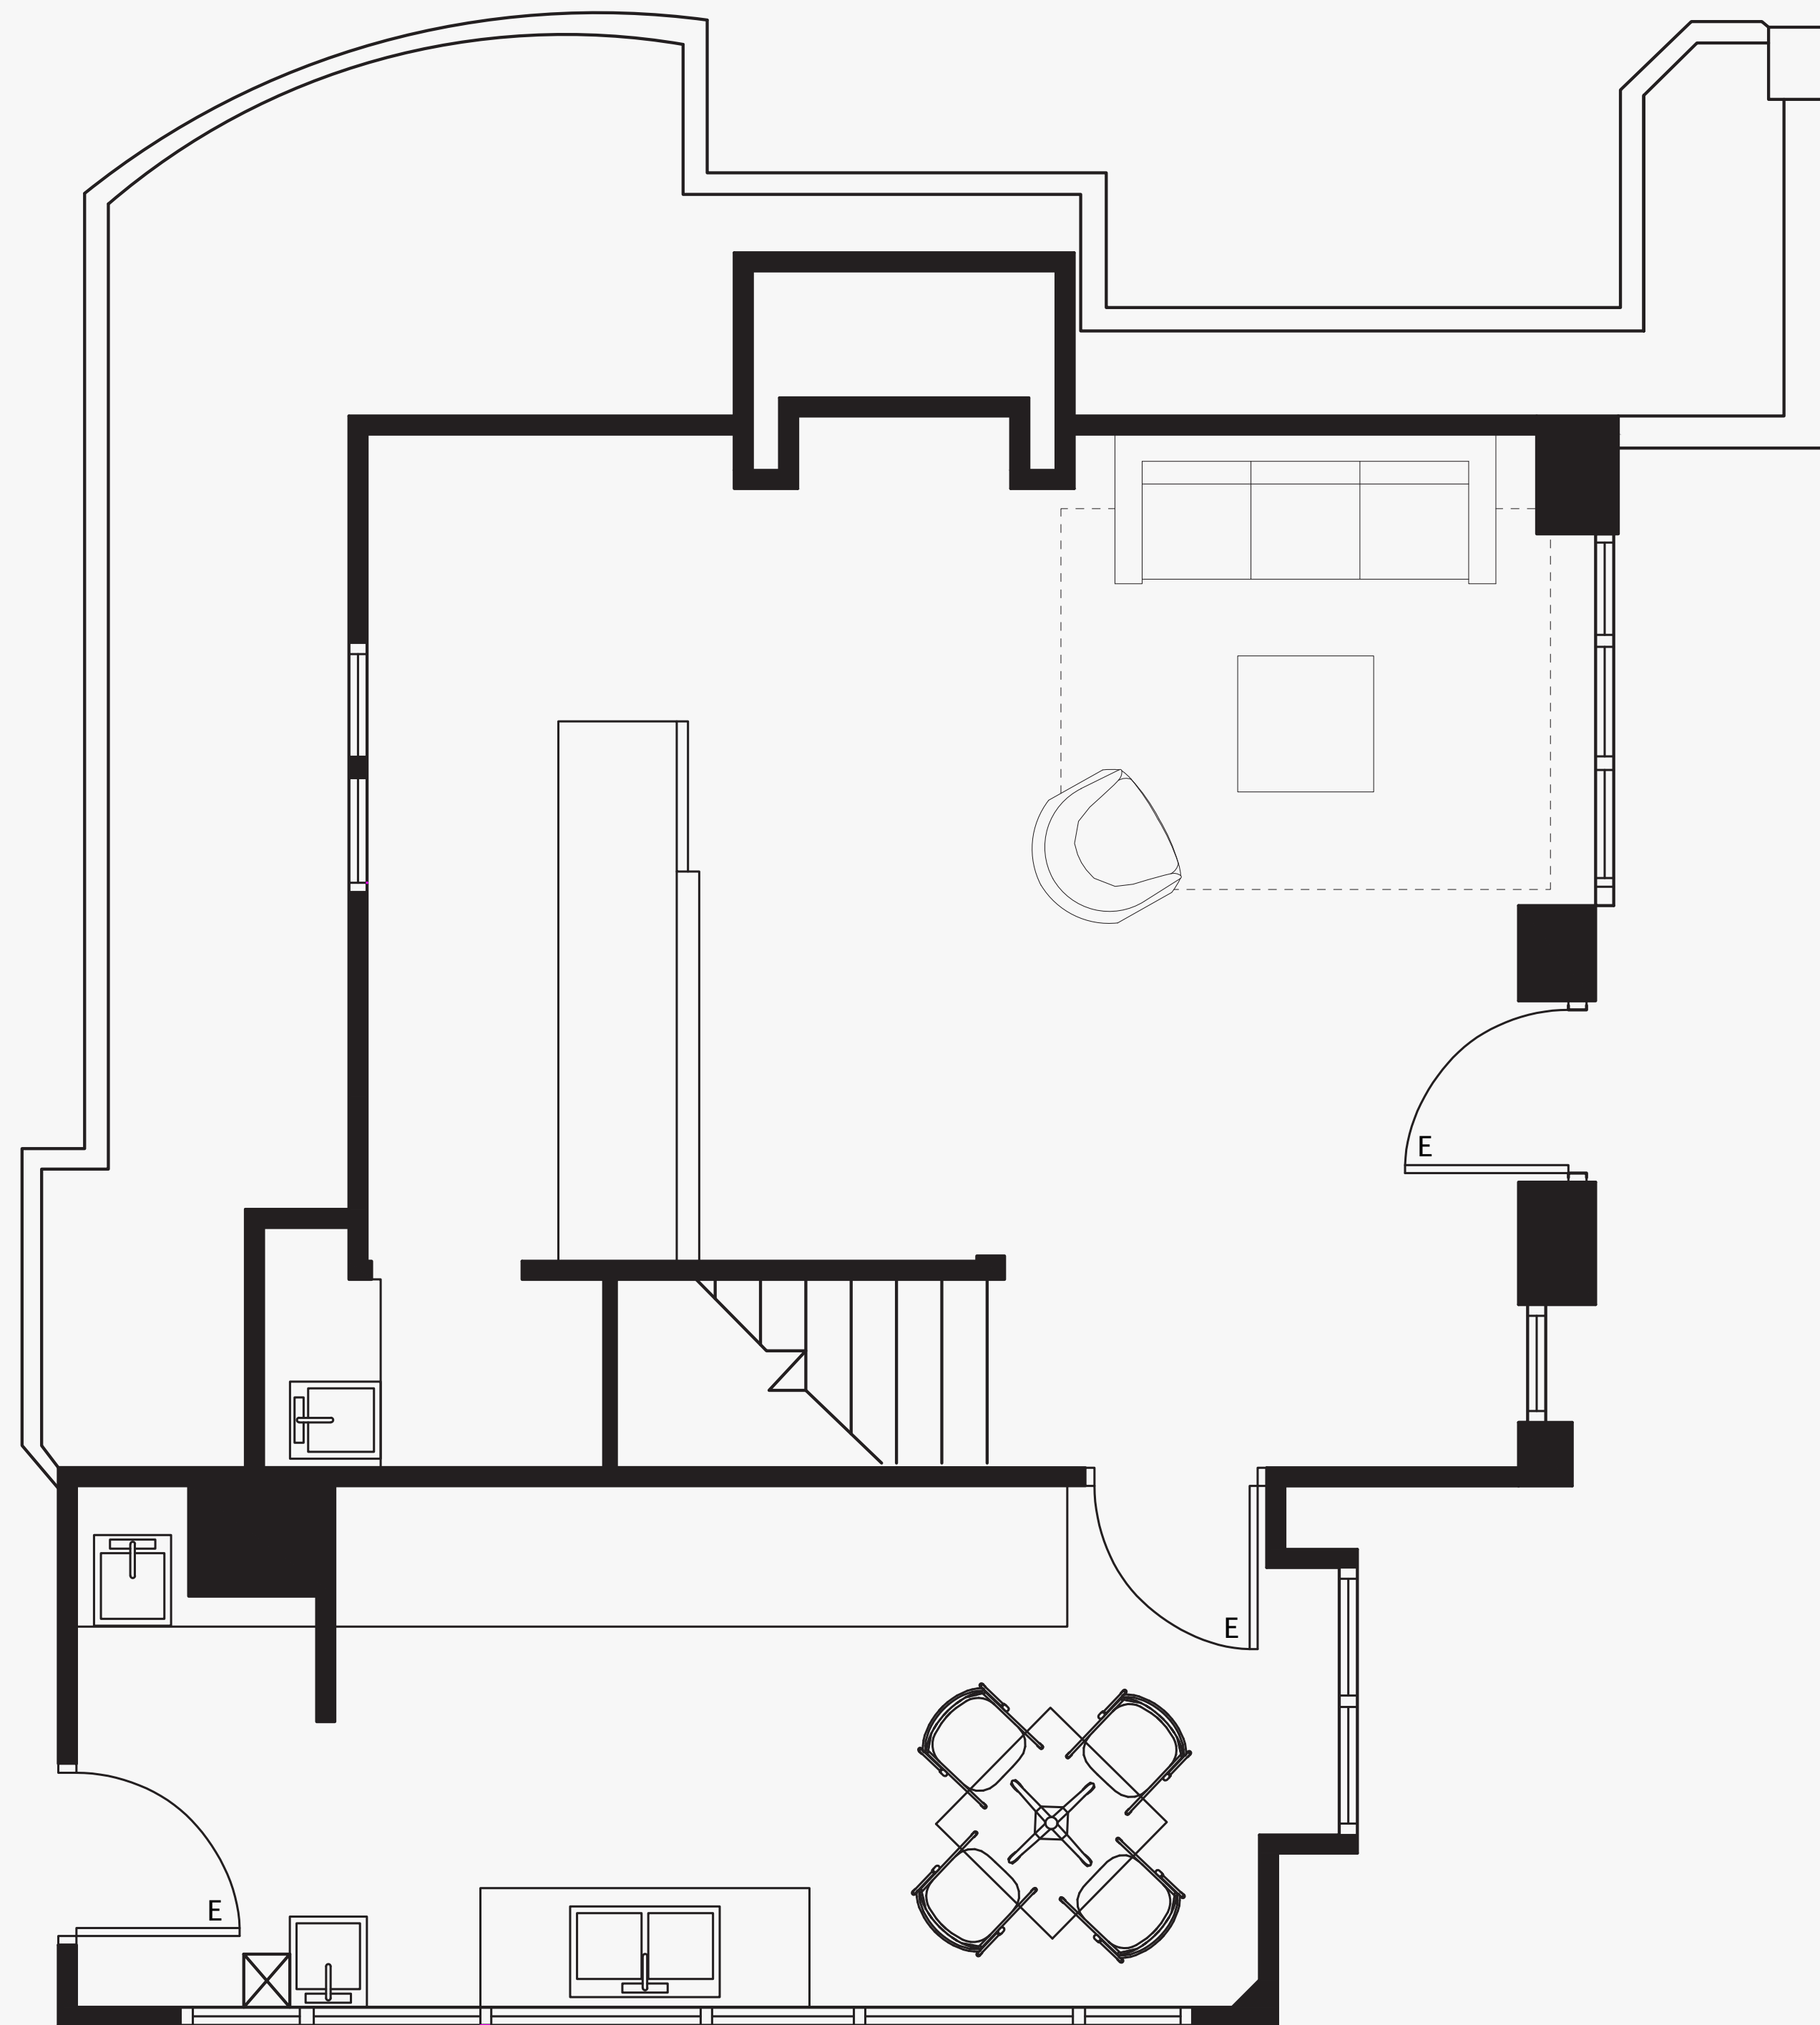



AS-BUILT CONFIGURATION

- OFFICES..... 2
- KITCHEN..... 1
- OPEN WORK AREA..... 1
- BATHROOM..... 1

KEY PLAN
(FURNITURE AND APPLIANCES NOT INCLUDED)

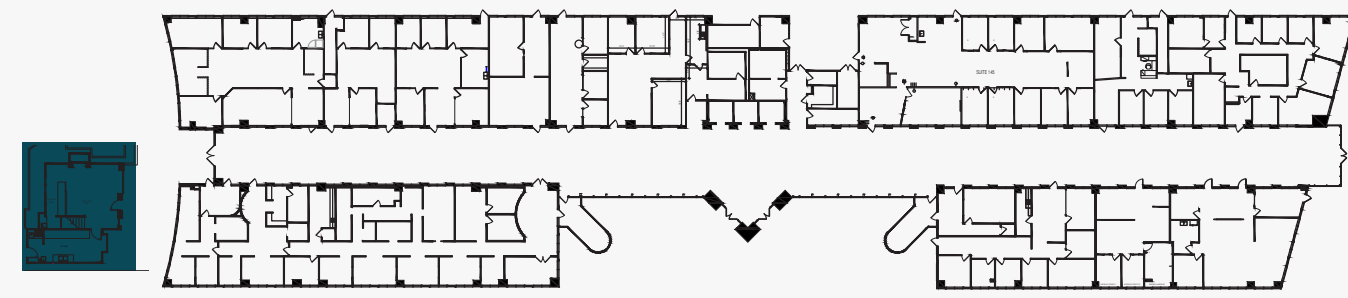

LOWER LEVEL

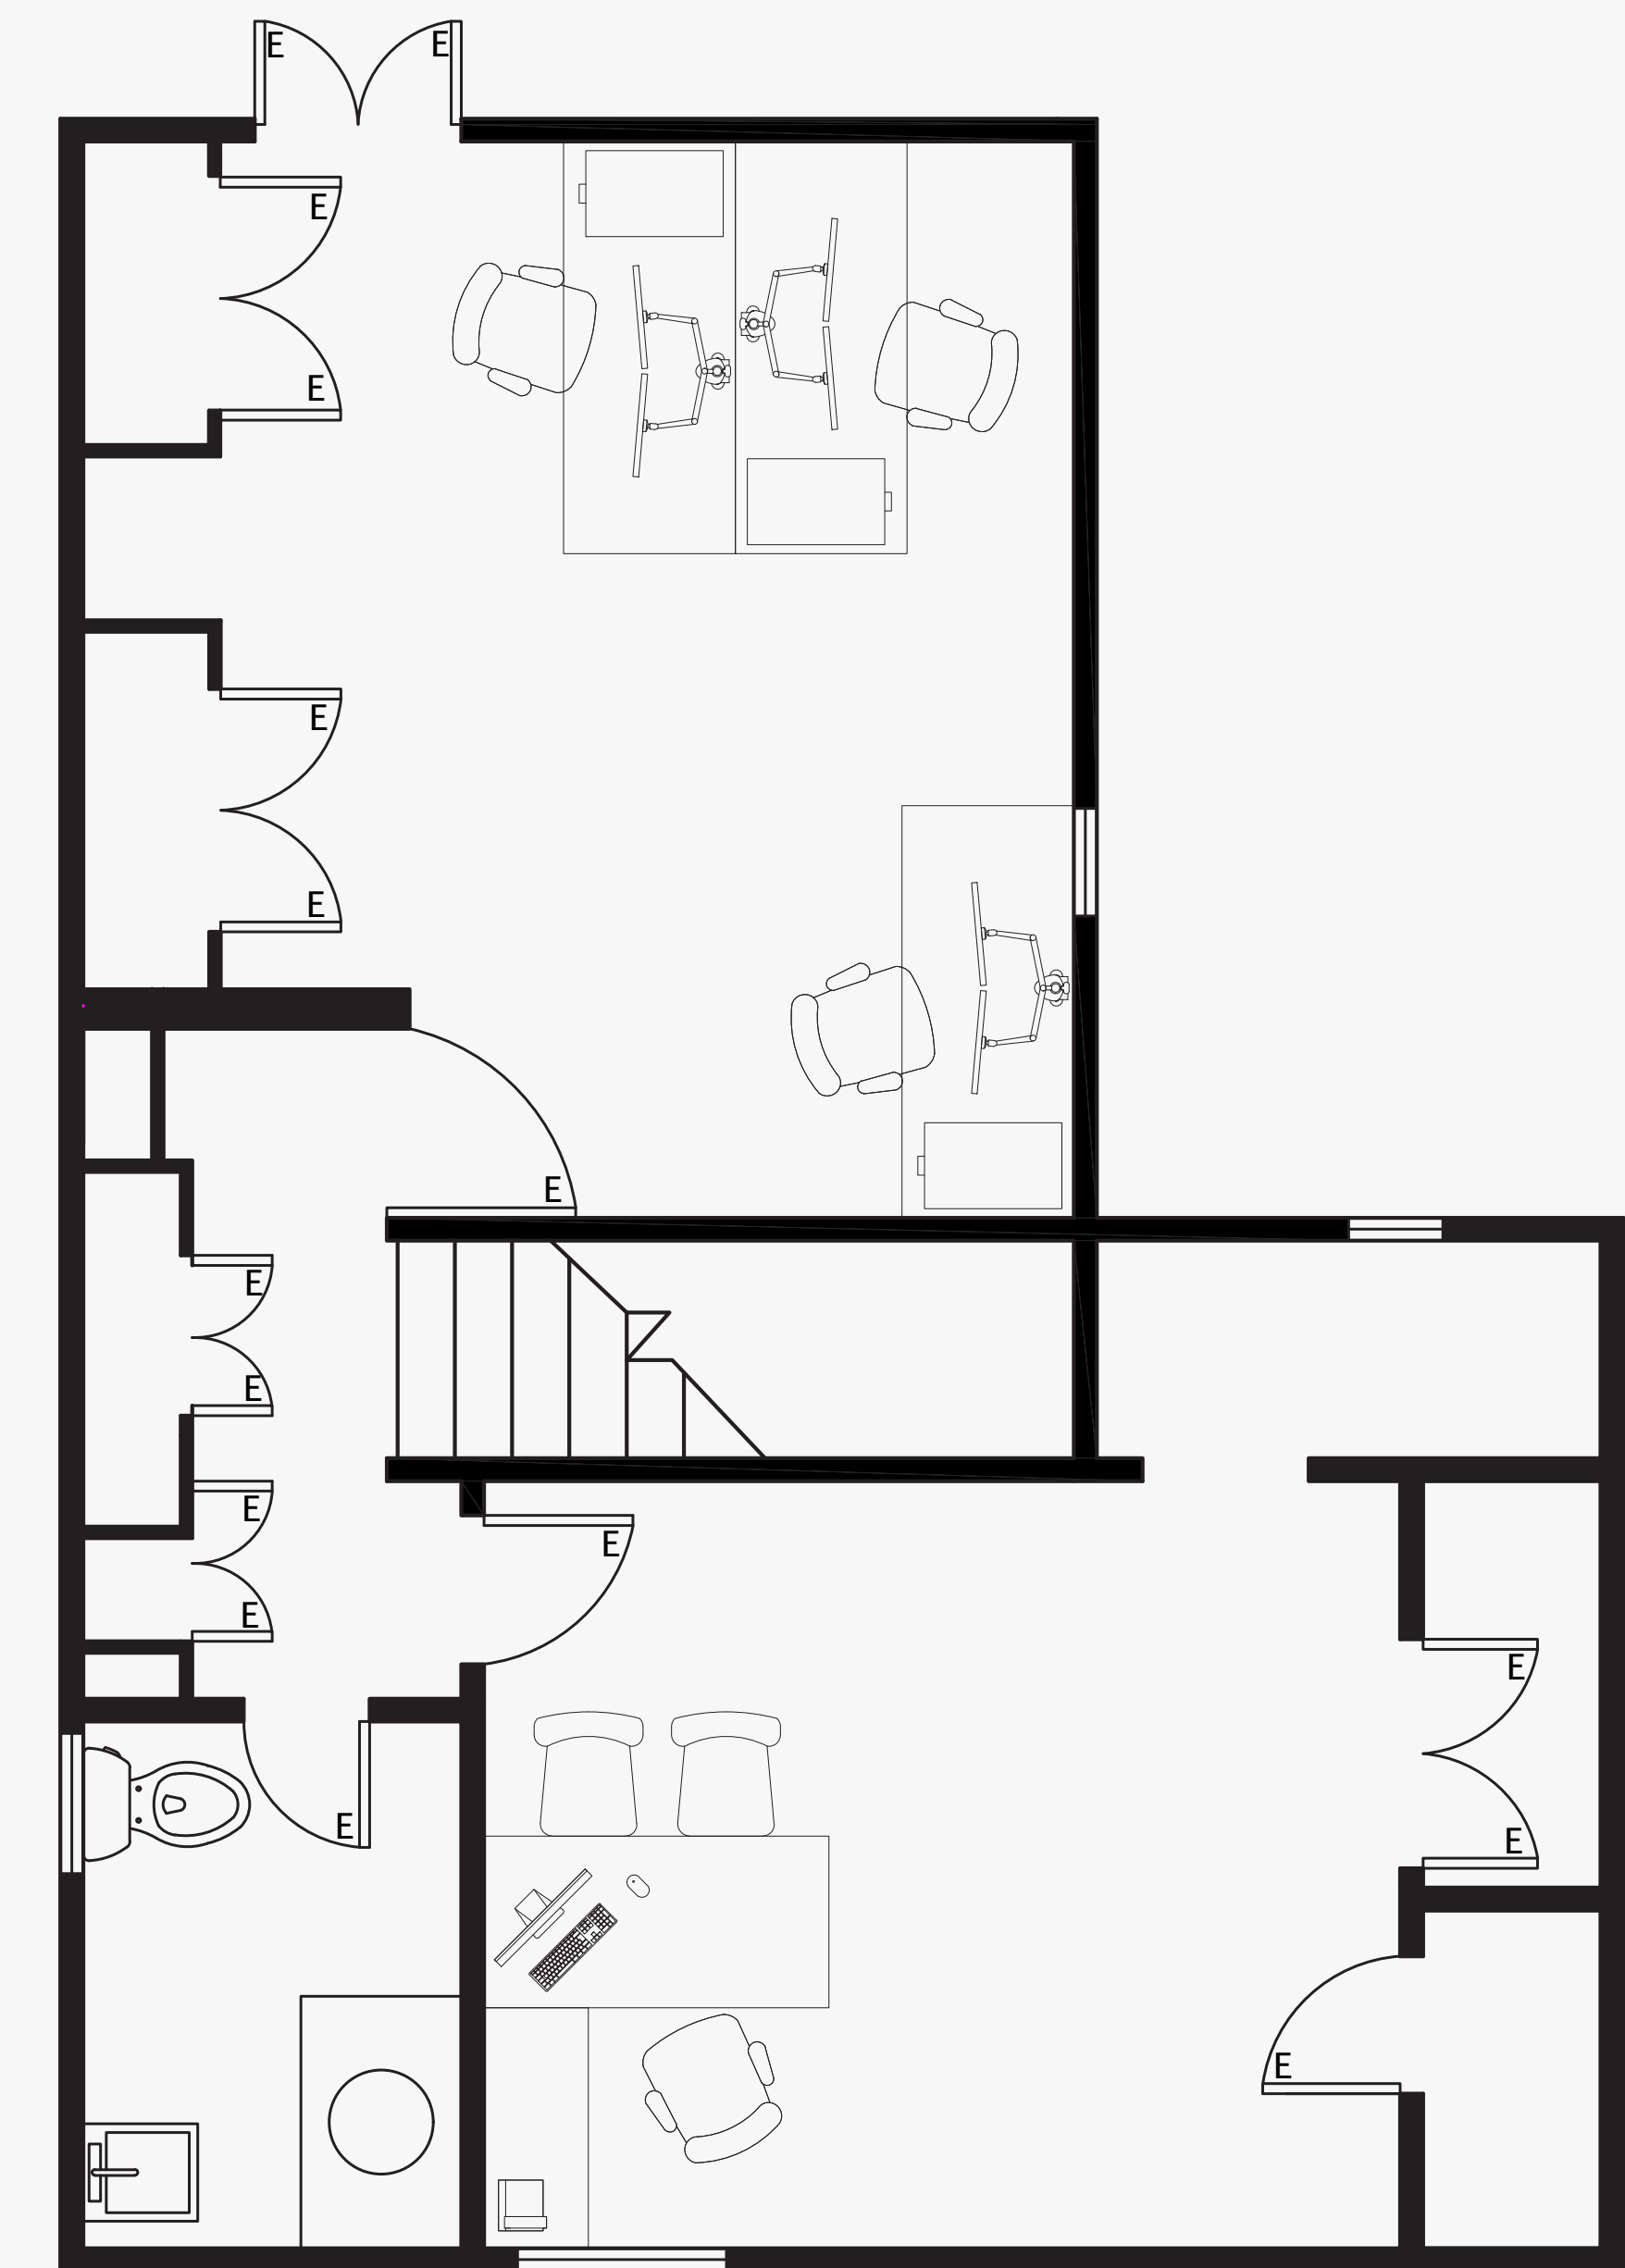

UPPER LEVEL

For leasing information please contact:

Josh Bernstein

310.228.1425

josh.bernstein@cushwake.com

Scott Menkus

310.595.2211

scott.menkus@cushwake.com

Pete Collins

310.595.2227

pete.collins@cushwake.com