
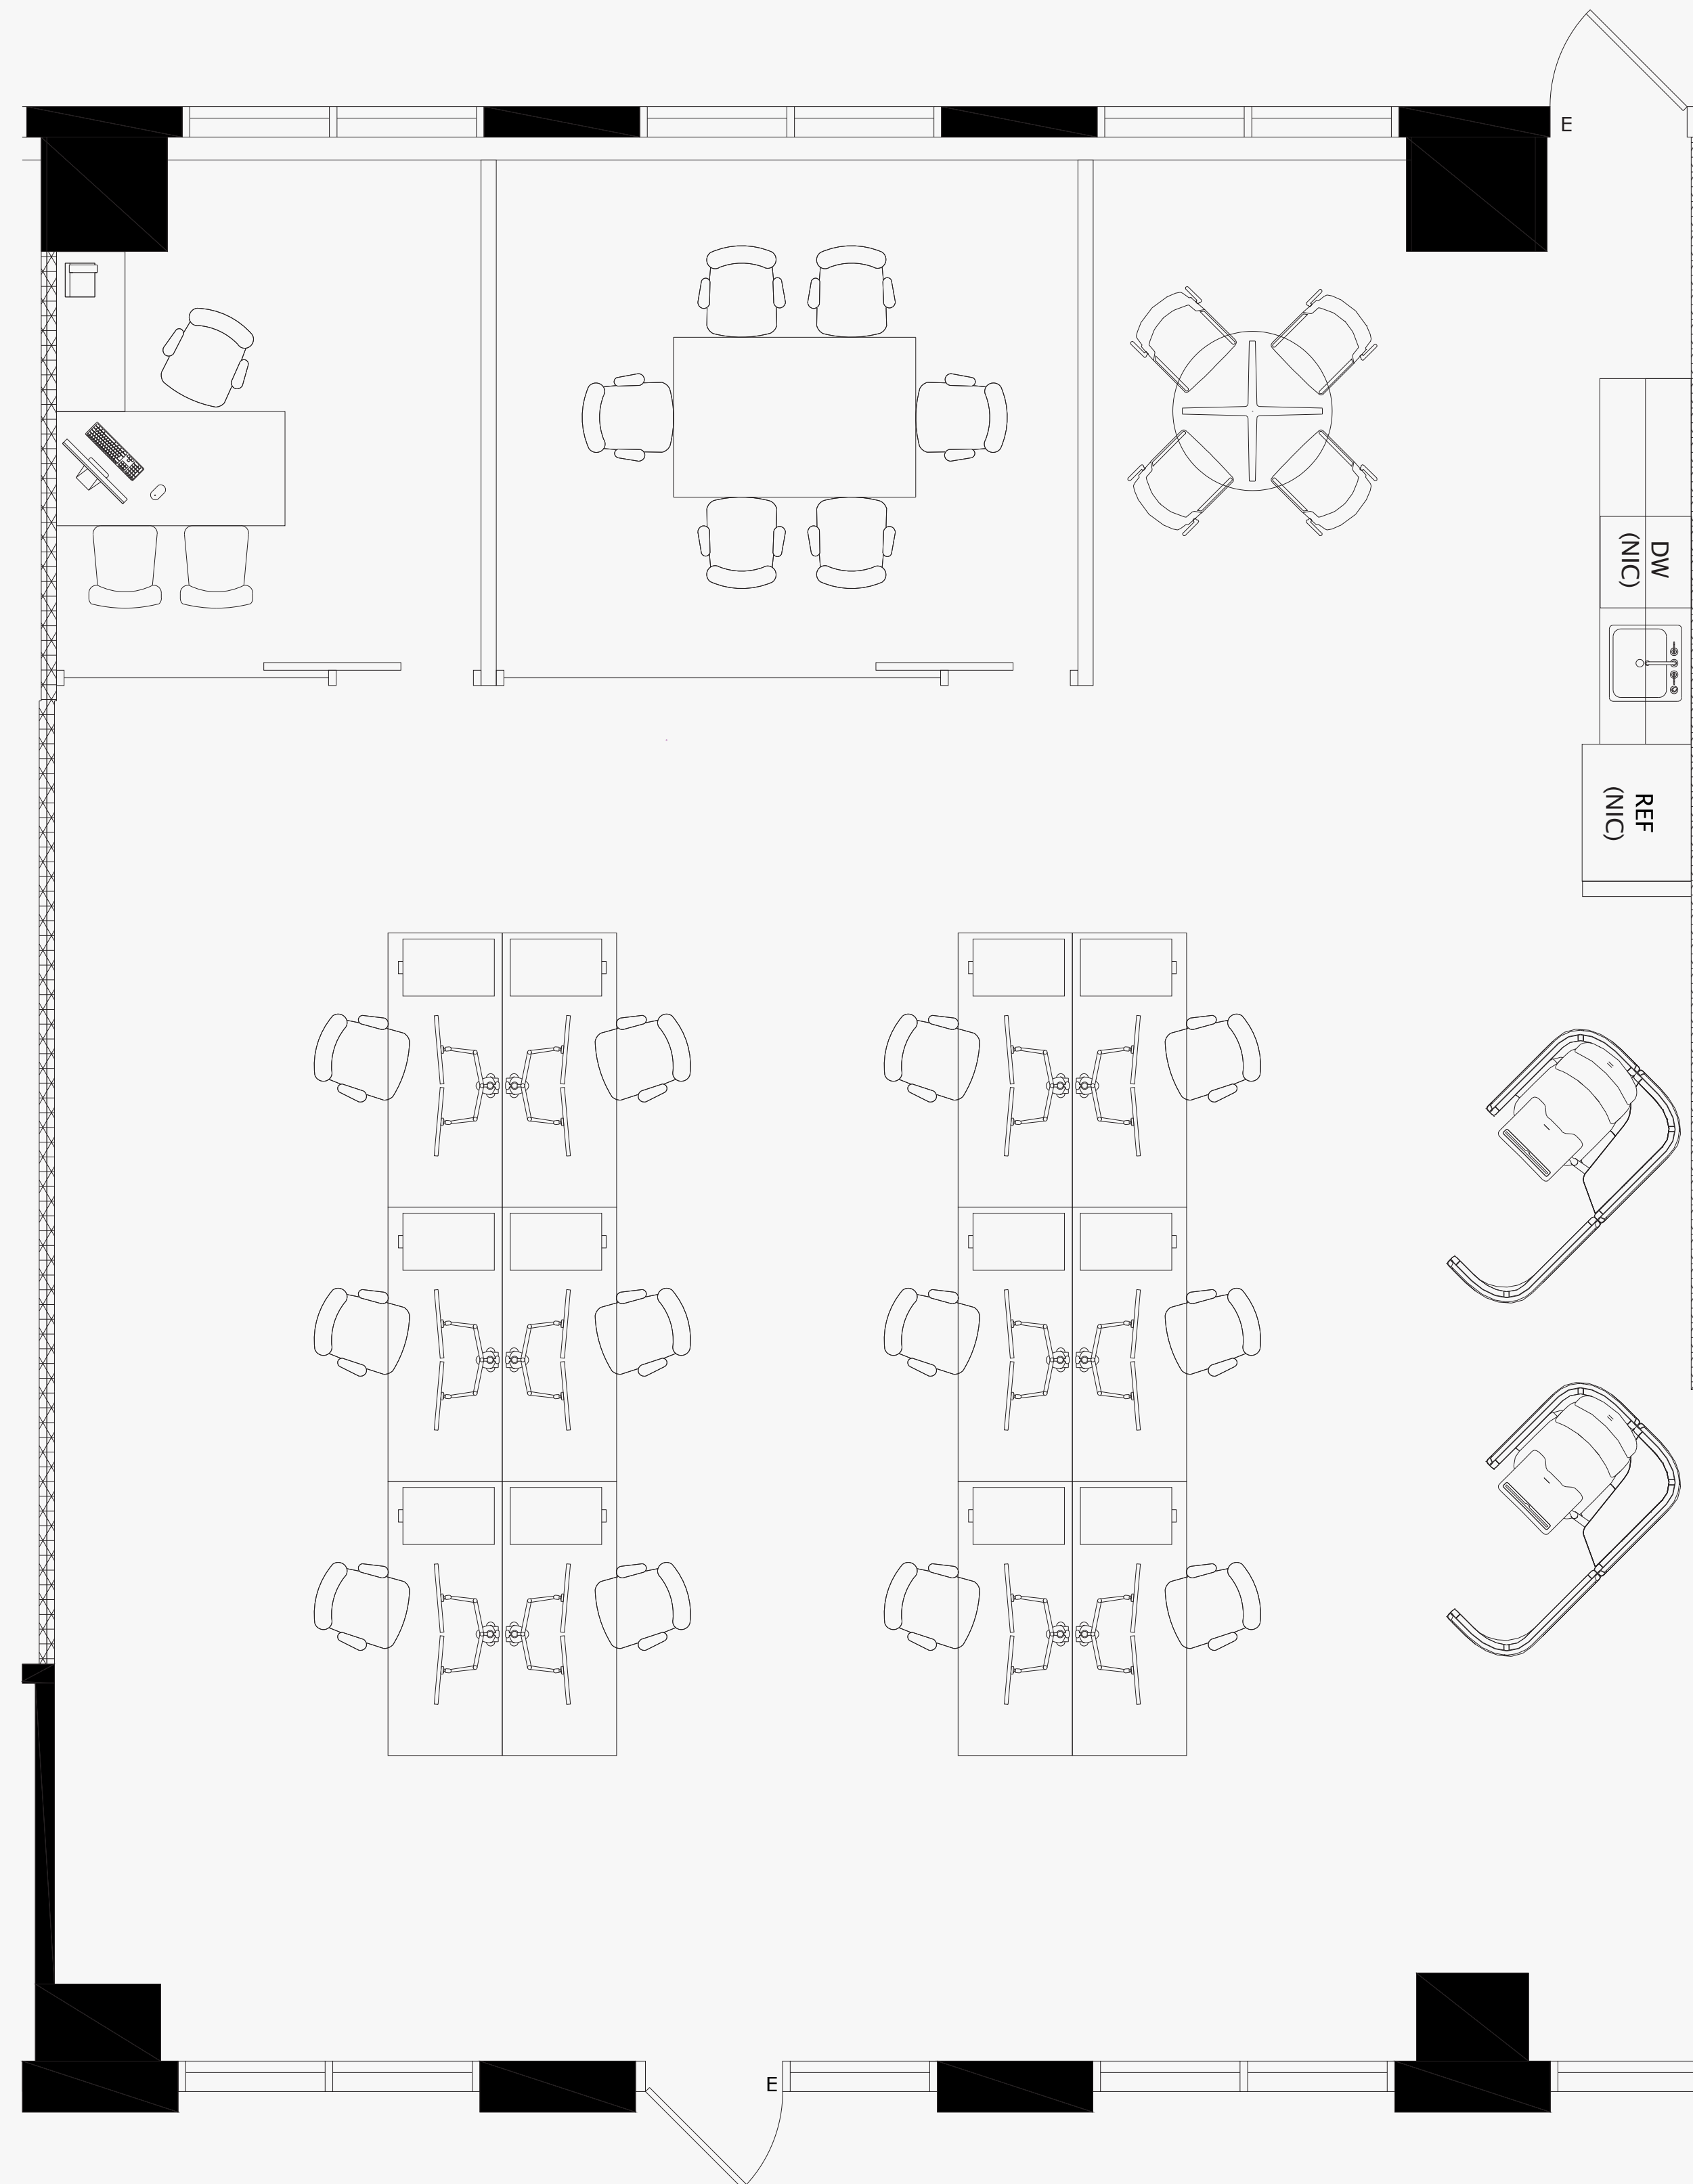


AS-BUILT CONFIGURATION

- OFFICES..... 1
- RECEPTION..... 1
- CONFERENCE ROOMS..... 1
- KITCHEN/BREAKOUT 1
- OPEN WORK AREA..... +/- 12

KEY PLAN

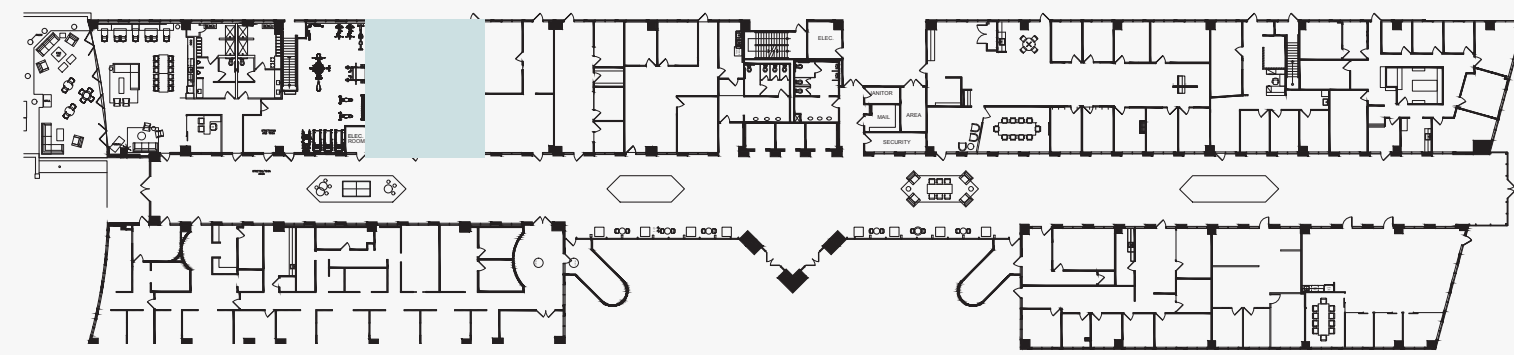

For leasing information please contact:

Josh Bernstein

310.228.1425

josh.bernstein@cushwake.com

Scott Menkus

310.595.2211

scott.menkus@cushwake.com

Pete Collins

310.595.2227

pete.collins@cushwake.com