

SUITE: 115


RSF: 1,849

ATRIA WEST

AS-BUILT CONFIGURATION

OFFICES.....	1
RECEPTION.....	1
CONFERENCE ROOMS.....	1
KITCHEN/BREAKOUT	1
OPEN WORK AREA.....	16+

KEY PLAN

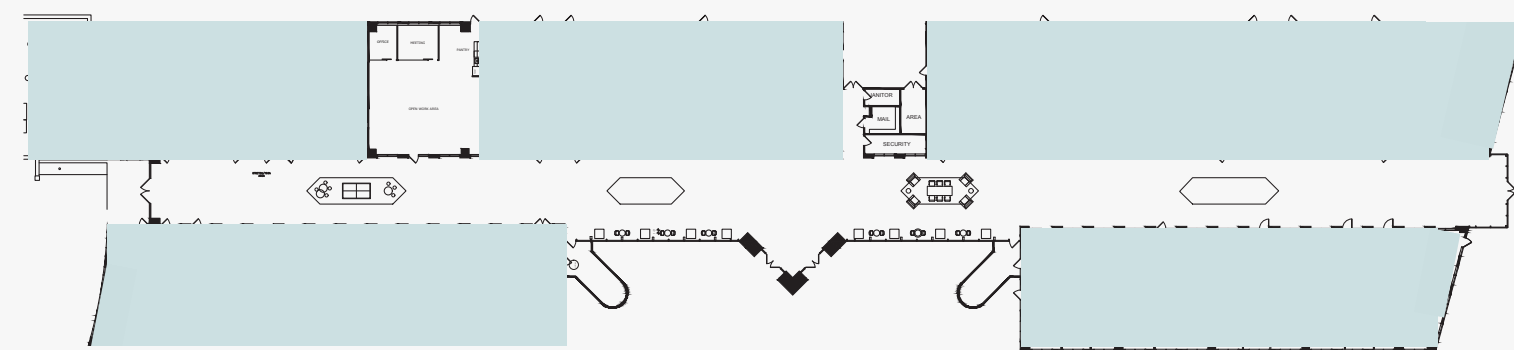

For leasing information please contact:

Peter Best

310.407.3422

pbest@larealtypartners.com

Lisa St. John

310.407.3422

lstjohn@lapartners.com

Owen Fileti

310.407.3409

ofileti@lapartners.com

Mac Burridge

310.407.3425

mburridge@lapartners.com

