

SUITE: 115



RSF: 1,849

AS-BUILT CONFIGURATION

- OFFICES.....1
- CONFERENCE ROOMS.....1
- KITCHEN/BREAKOUT1
- OPEN WORK AREA.....+/- 12

KEY PLAN

Not to scale, furniture and appliances not included

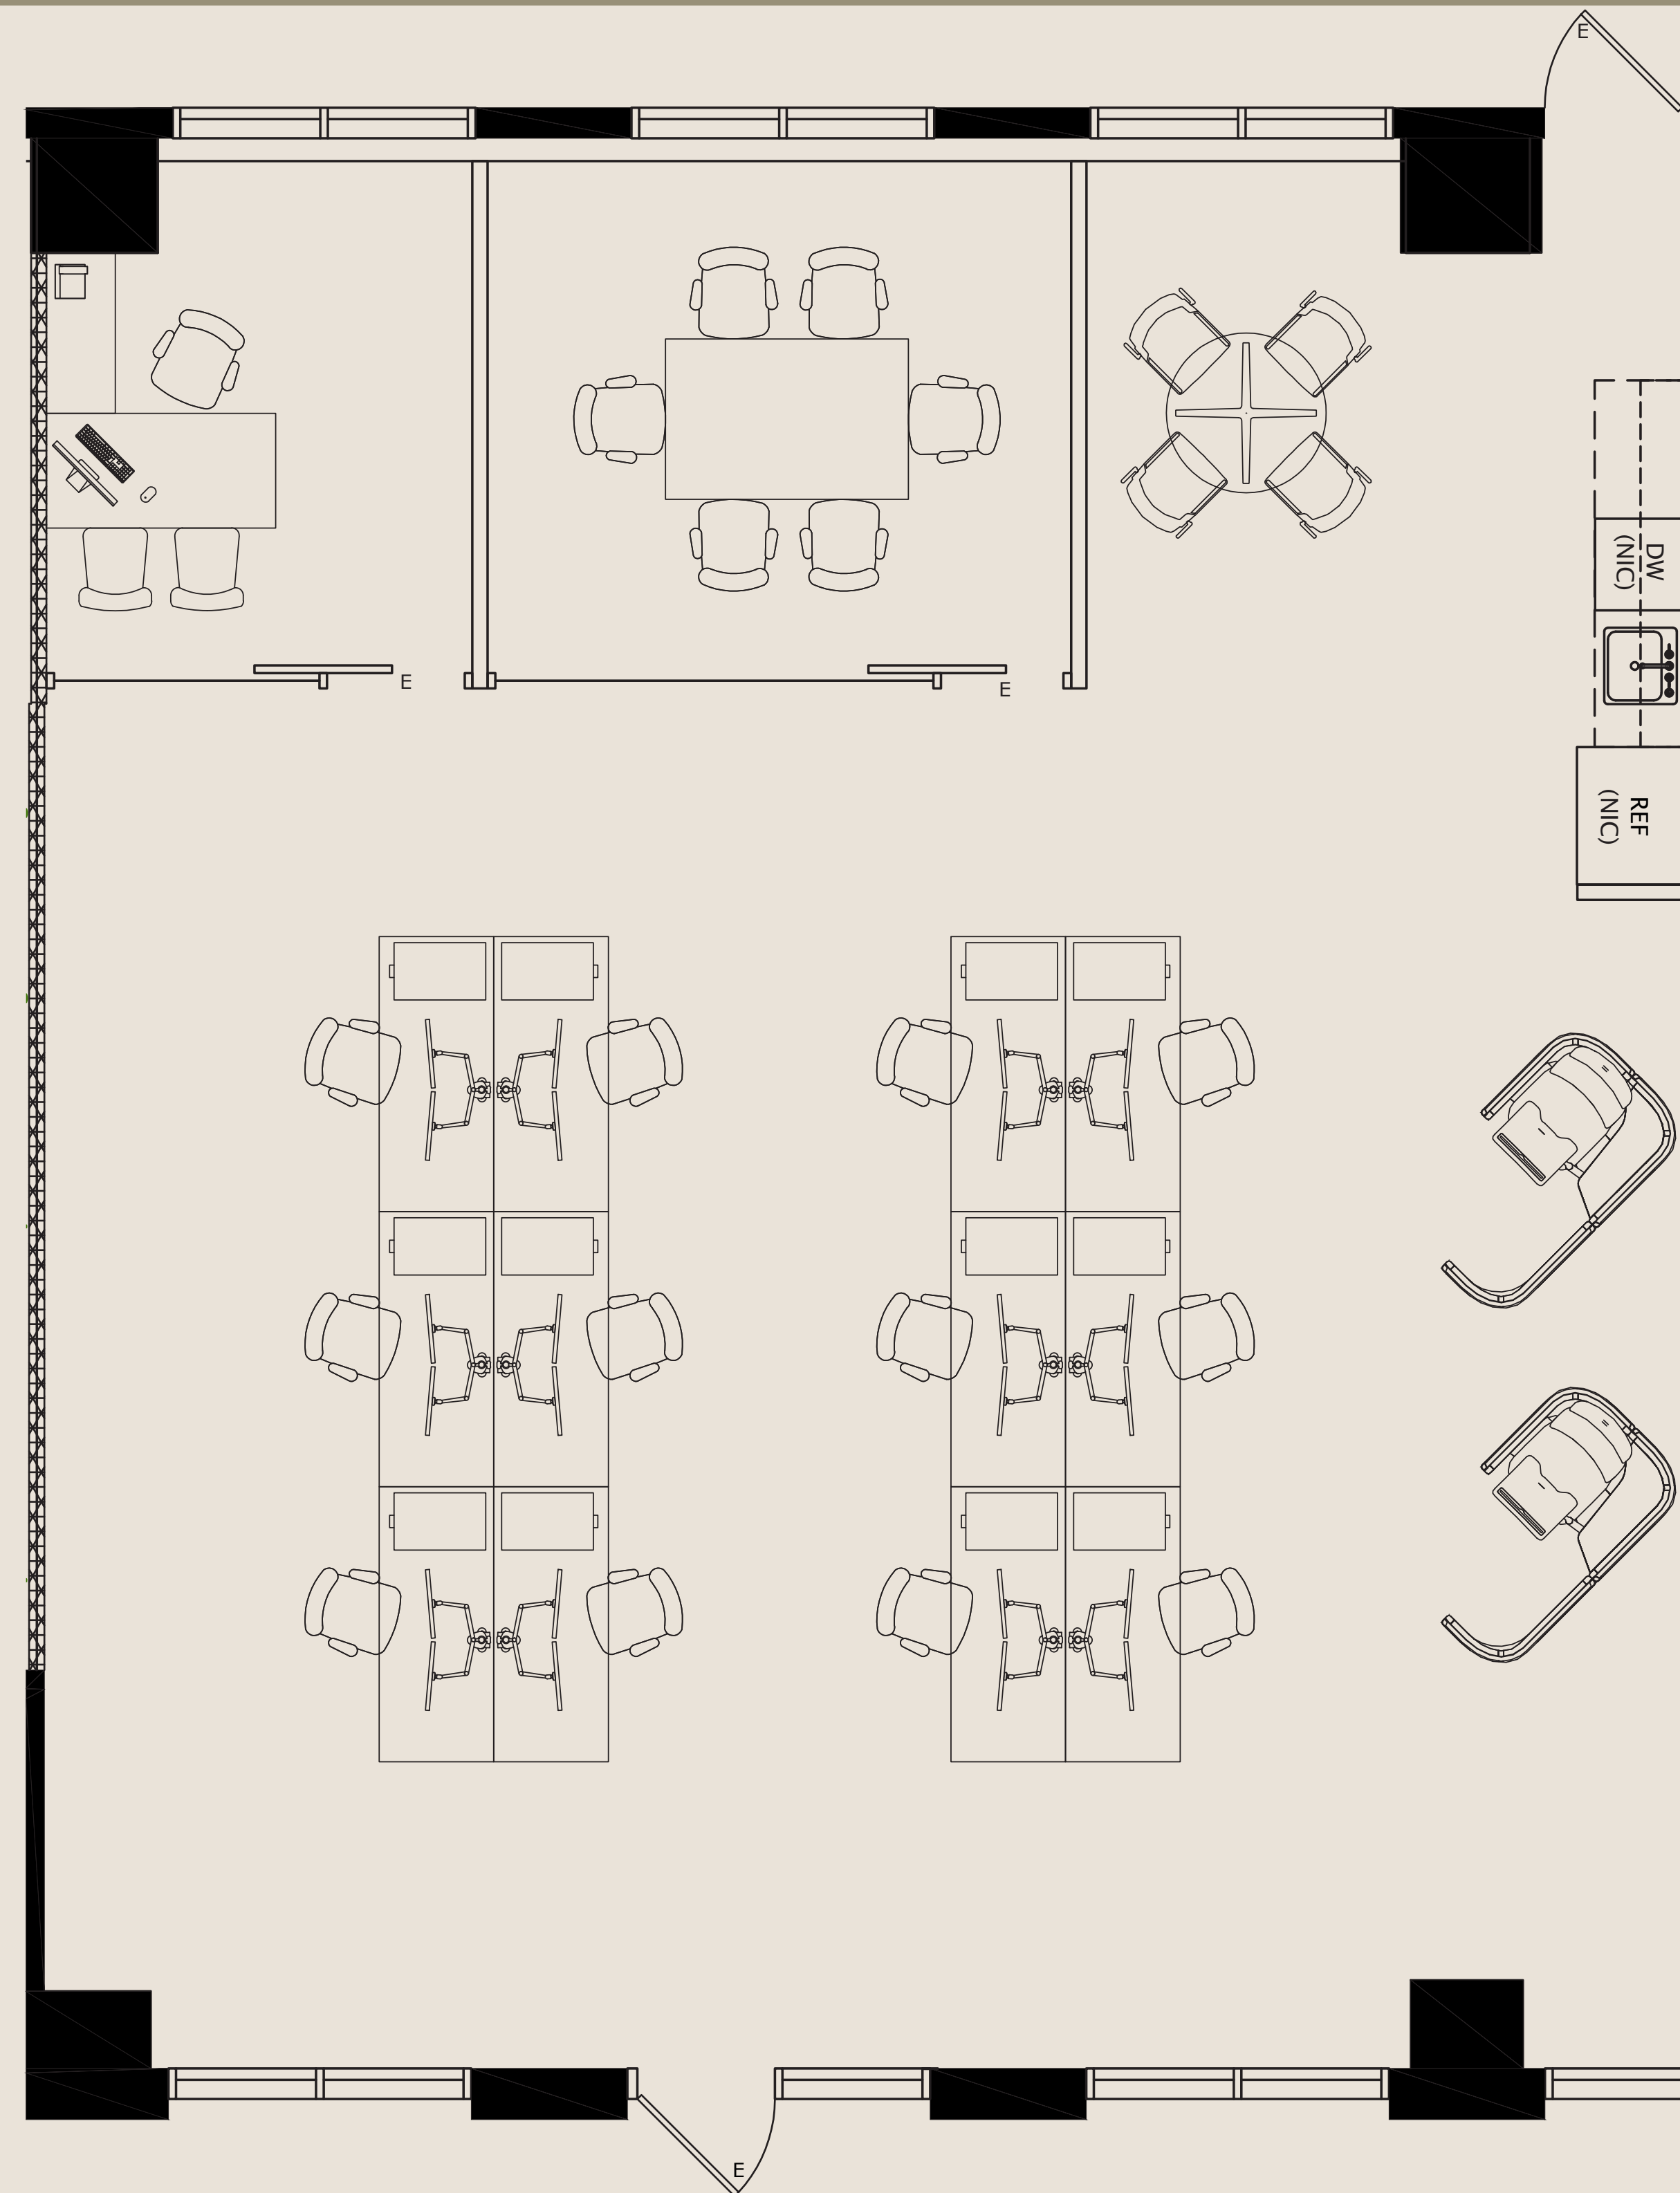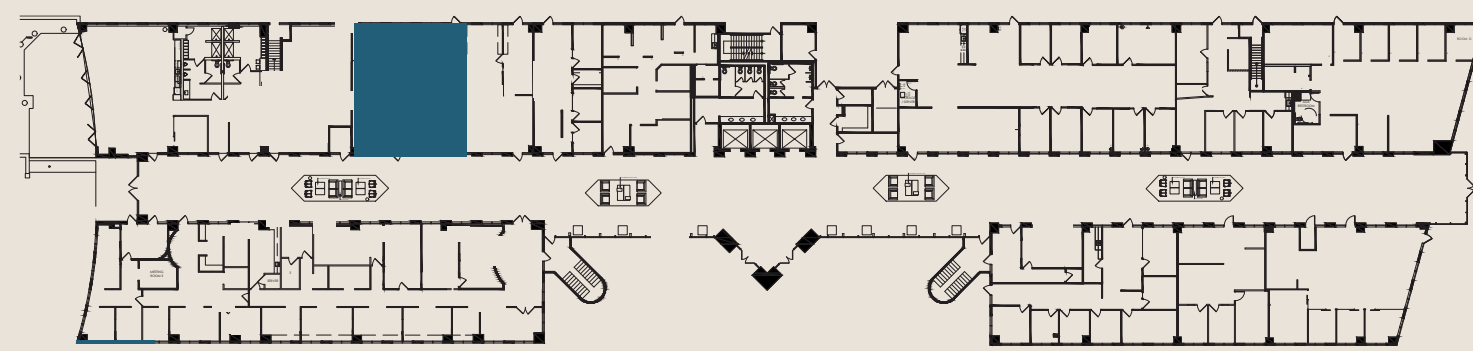

For leasing information please contact:
USALEASING@ONNI.COM
(213) 629 - 2041