

SUITE: 127

RSF: 2,834



ATRIA WEST

AS-BUILT CONFIGURATION

- OFFICES..... 1
- RECEPTION..... 1
- CONFERENCE ROOMS..... N/A
- KITCHEN/BREAKOUT N/A
- OPEN WORK AREA..... +/- 7

KEY PLAN

Not to scale, furniture and appliances not included

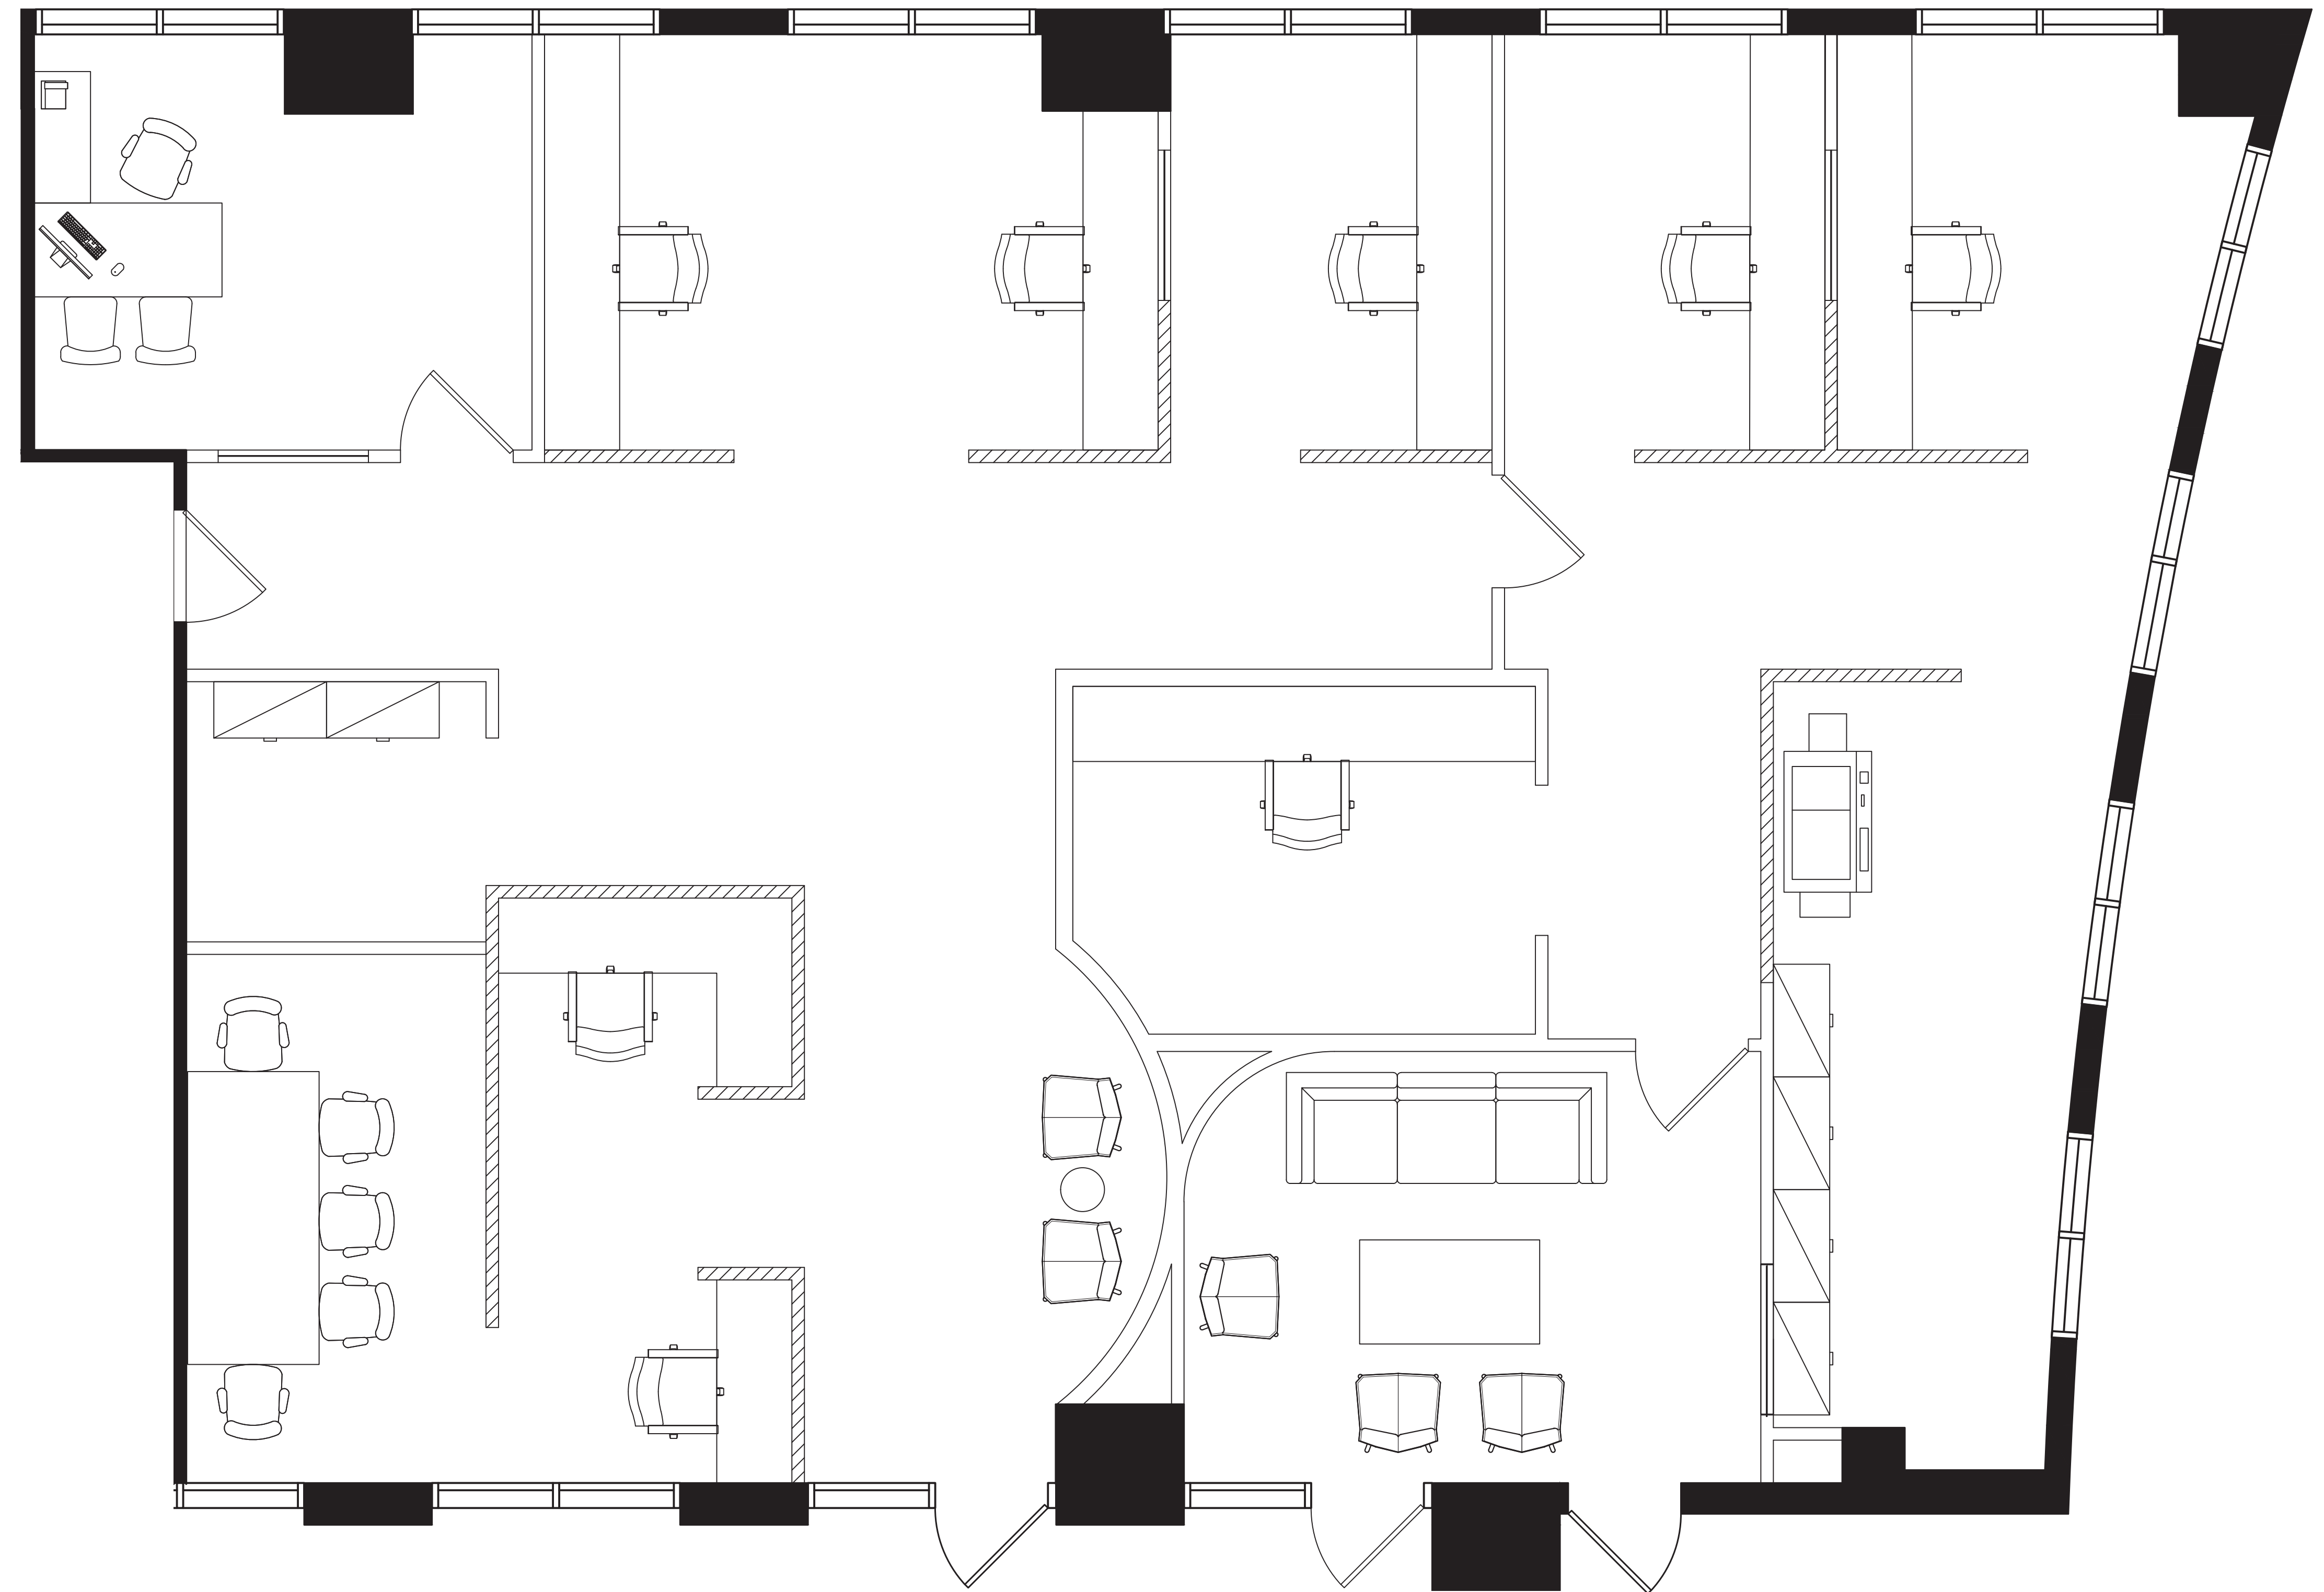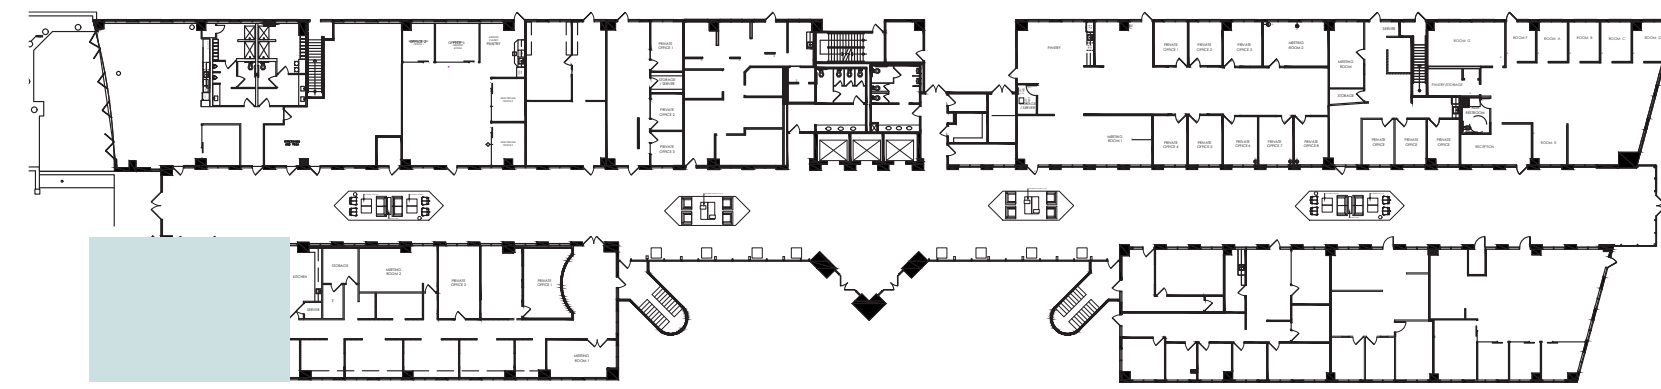

For further information, please contact:
USALEASING@ONNI.COM
(213) 629 - 2041

