

SUITE: 145

RSF: 5,306



ATRIA WEST

AS-BUILT CONFIGURATION

OFFICES.....	8
RECEPTION.....	1
CONFERENCE ROOMS.....	2
KITCHEN/BREAKOUT	1
OPEN WORK AREA.....	+/-18

KEY PLAN

Not to scale, furniture and appliances not included

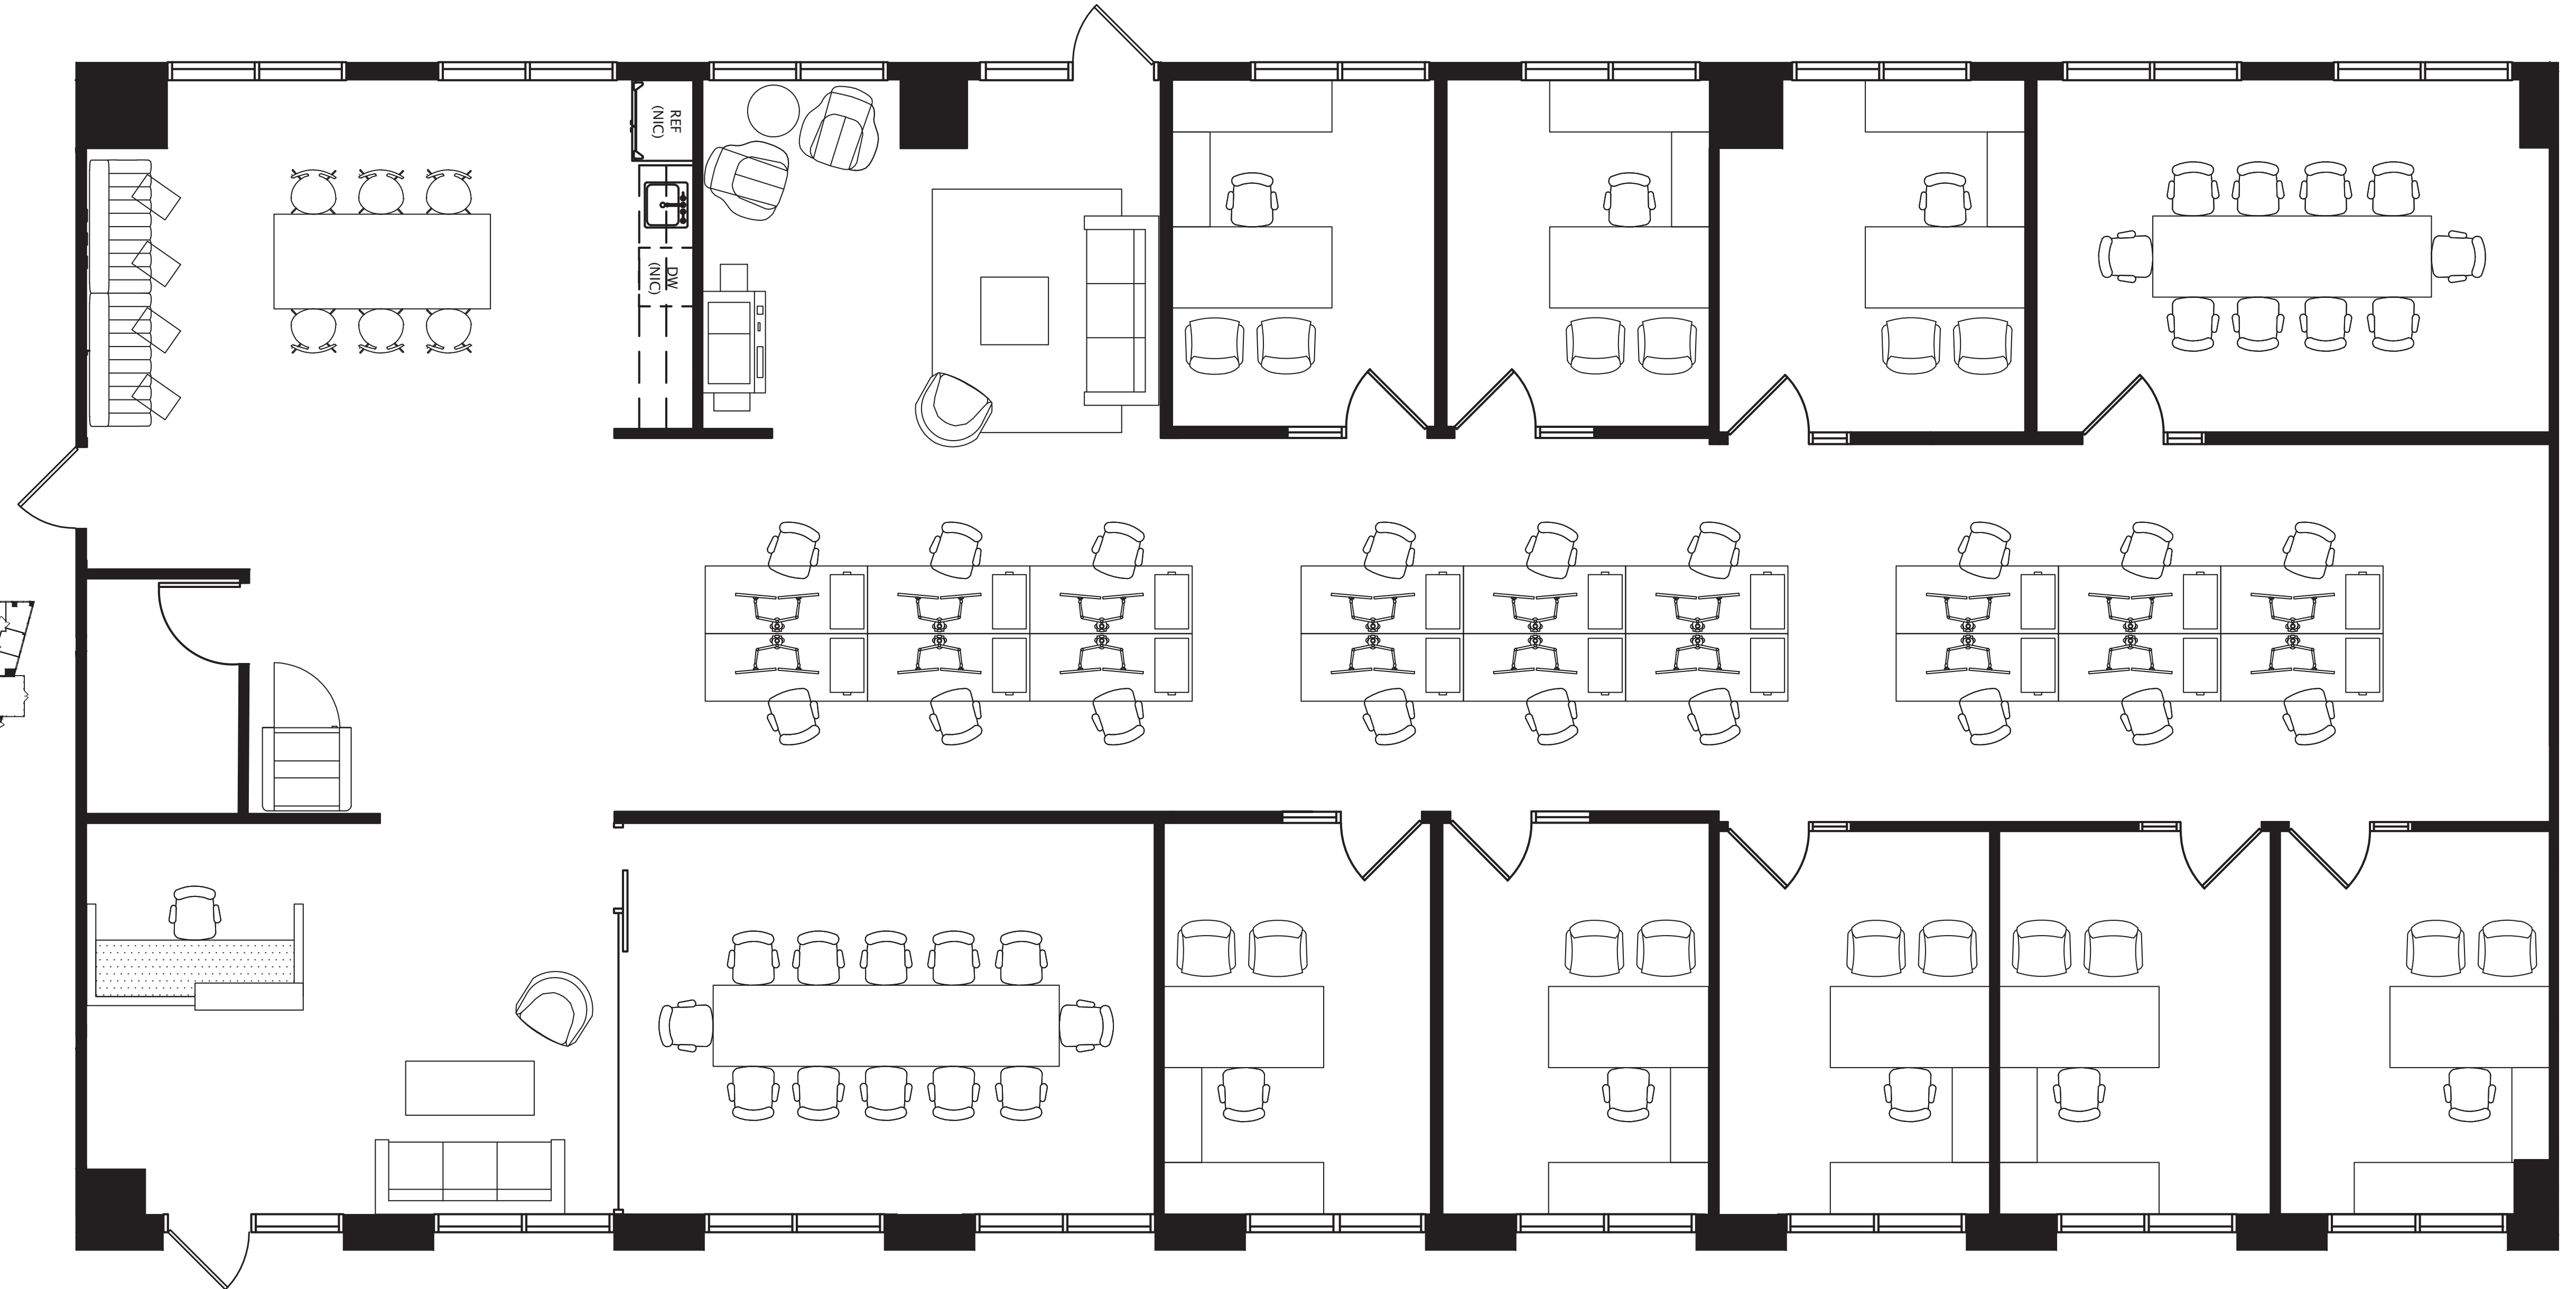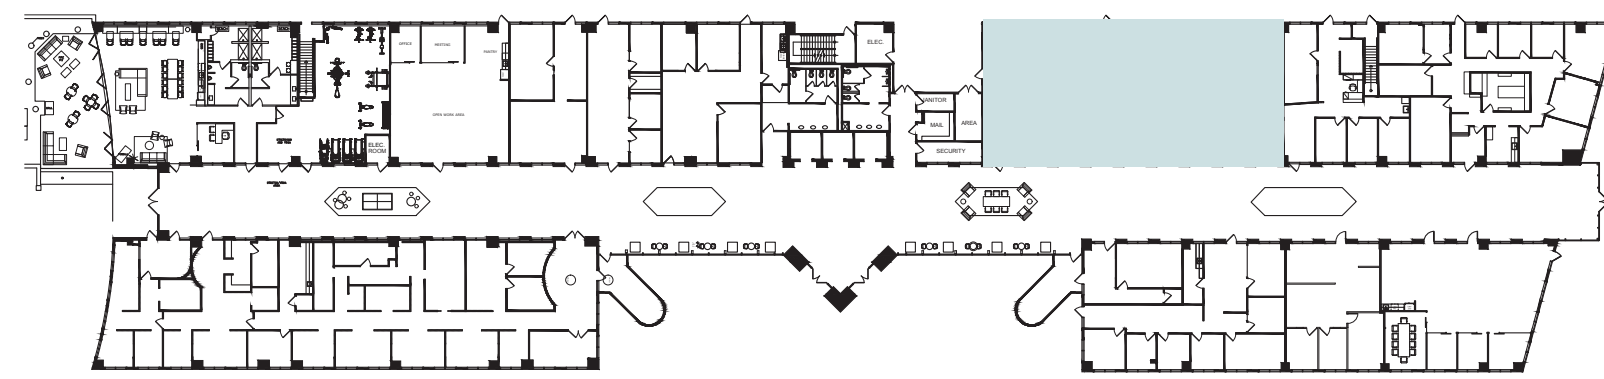

PLEASE CONTACT:
USALEASING@ONNI.COM
(213) 629 - 2041

