

SUITE: 160



RSF: 1,530

ATRIA WEST

AS-BUILT CONFIGURATION

OFFICES.....	3
RECEPTION.....	1
CONFERENCE ROOMS.....	1
KITCHEN/BREAKOUT	1
OPEN WORK AREA.....	TBD

KEY PLAN

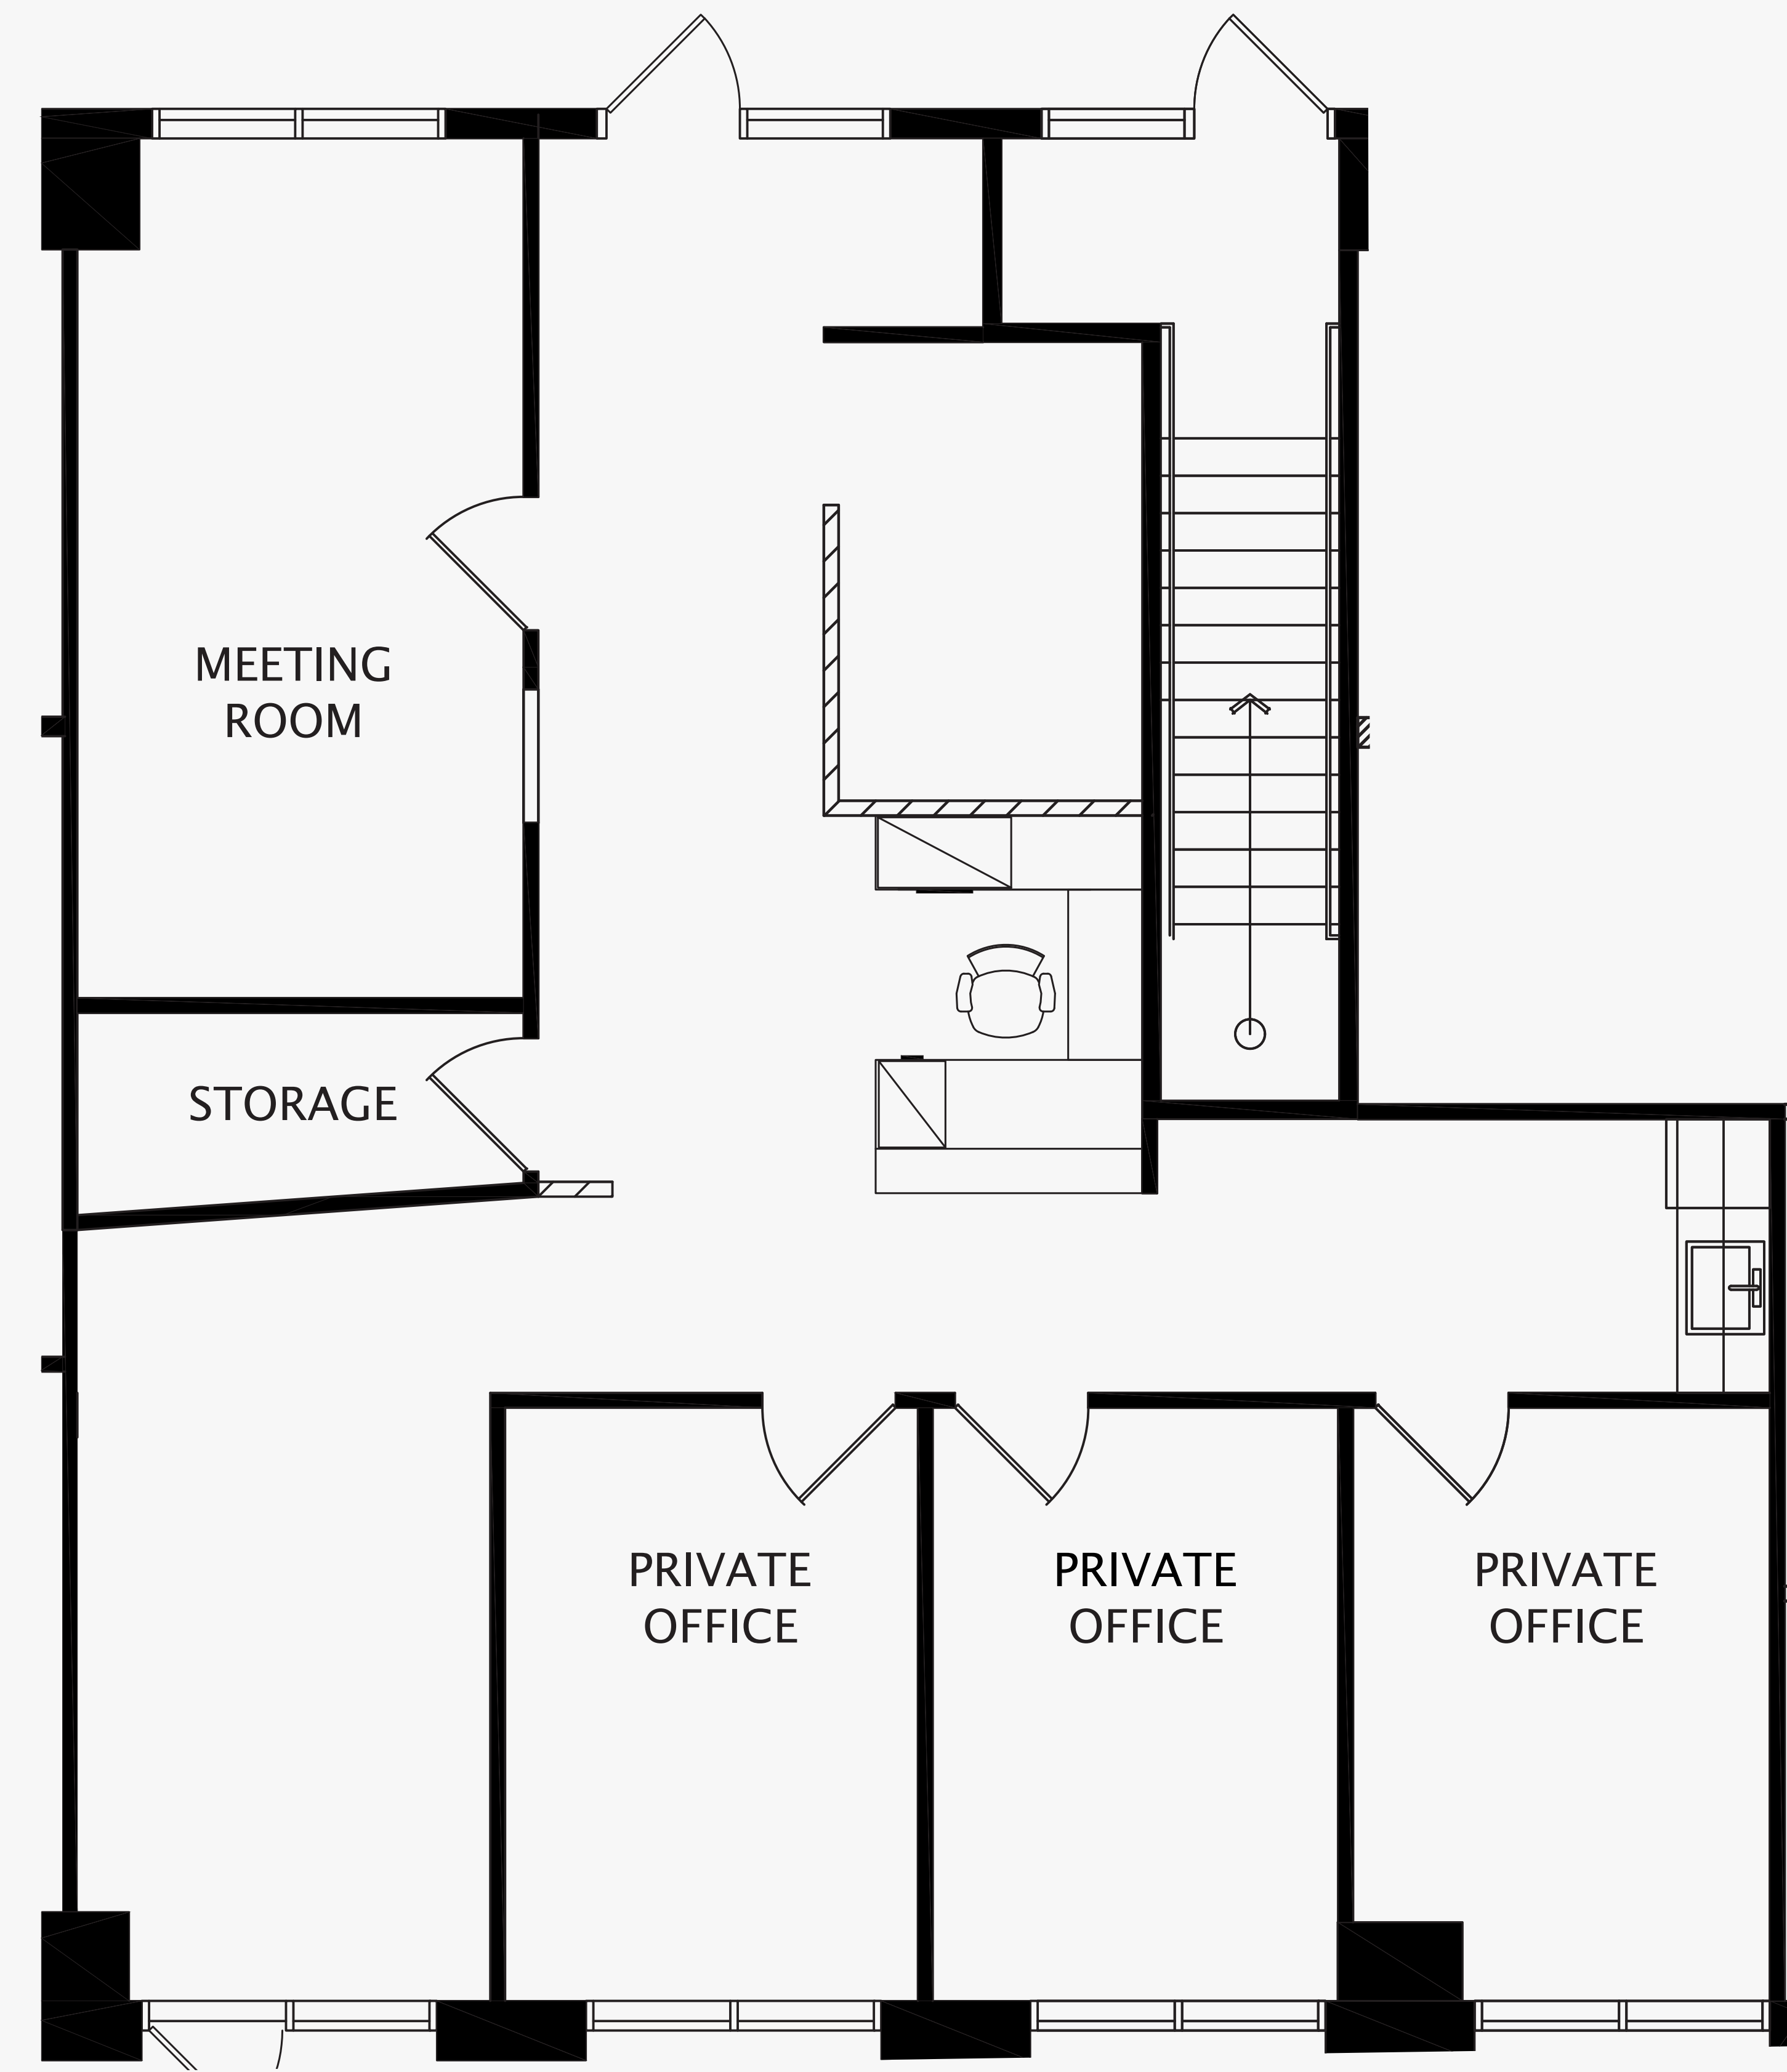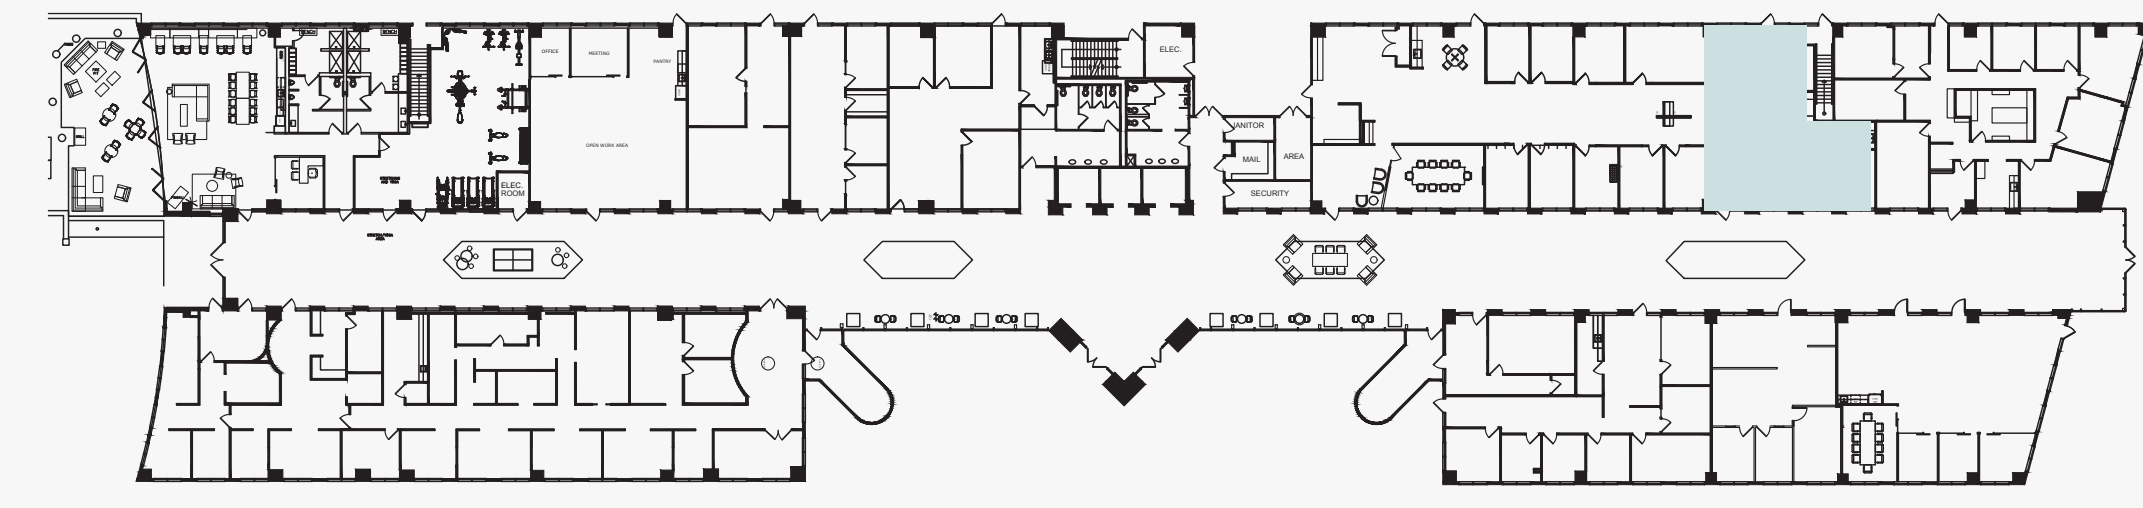

For leasing information please contact:
Andrew Tashjian
213 955 5148
andrew.tashjian@cushwake.com

Josh Bernstein
310 228 1425
josh.bernstein@cushwake.com

