

SUITE: 160



RSF: 1,769

ATRIA WEST

AS-BUILT CONFIGURATION

- OFFICES..... 3
- RECEPTION..... 1
- CONFERENCE ROOMS..... 1
- KITCHEN/BREAKOUT 1
- OPEN WORK AREA..... 1

KEY PLAN

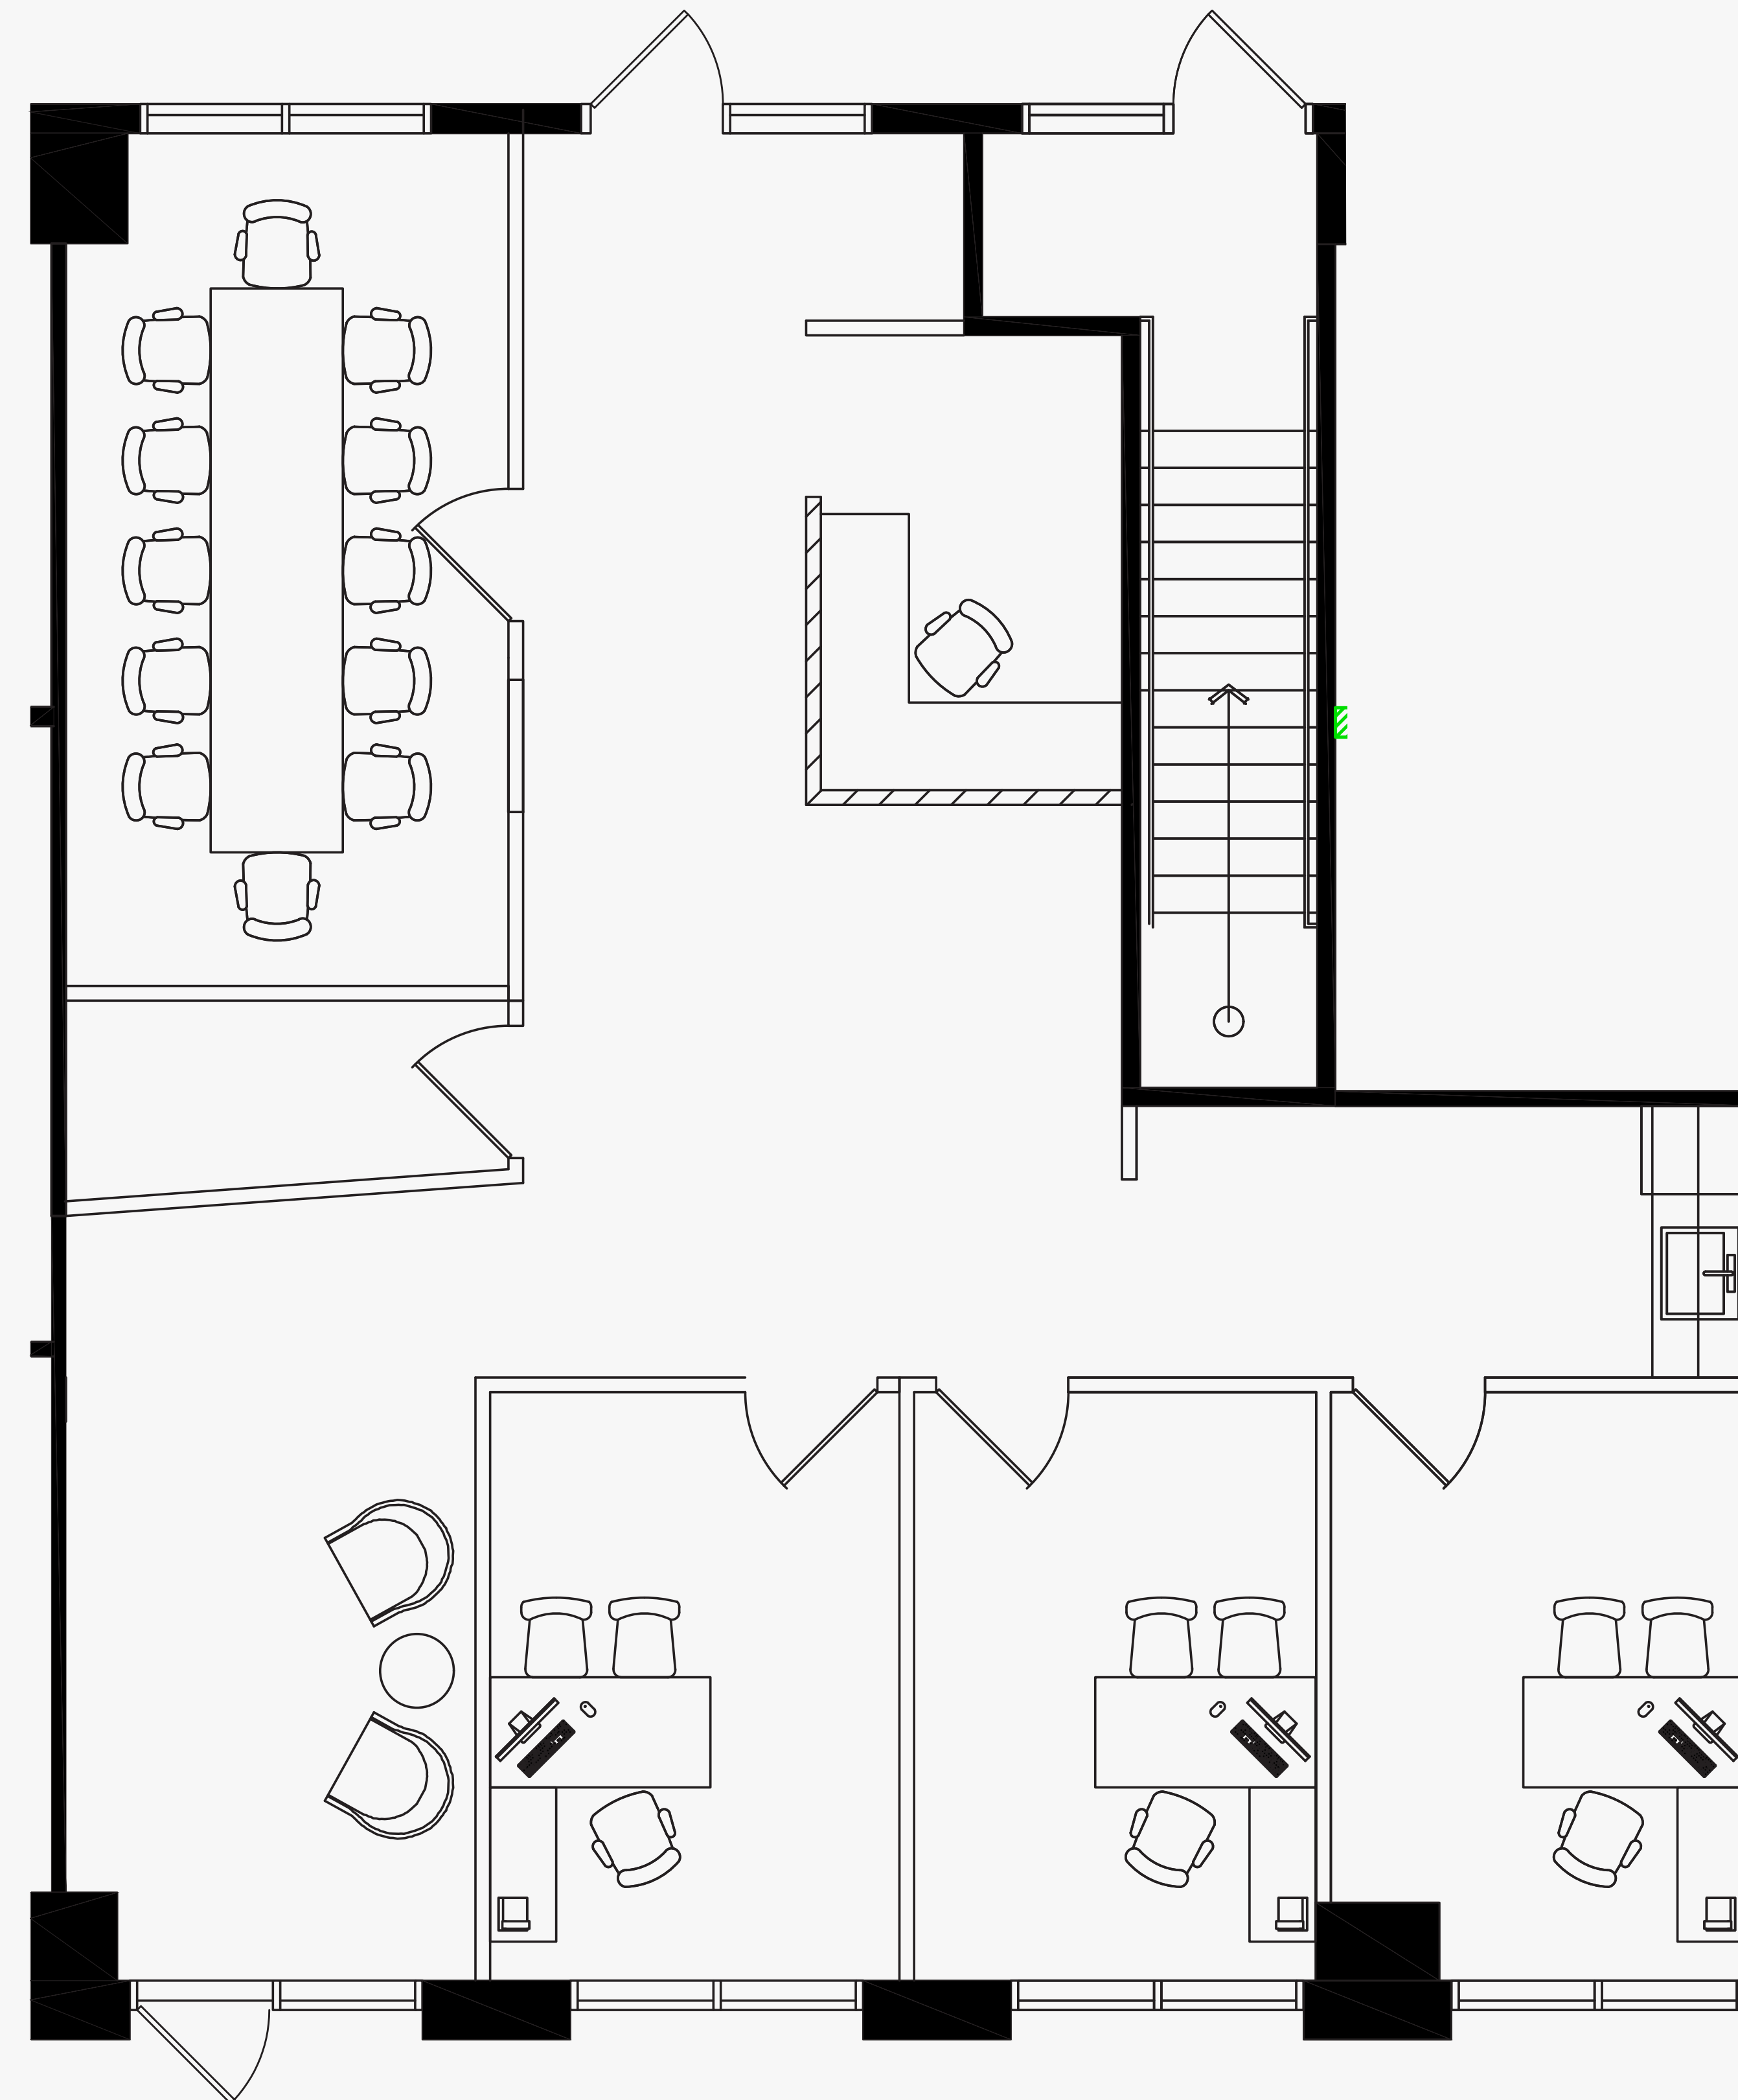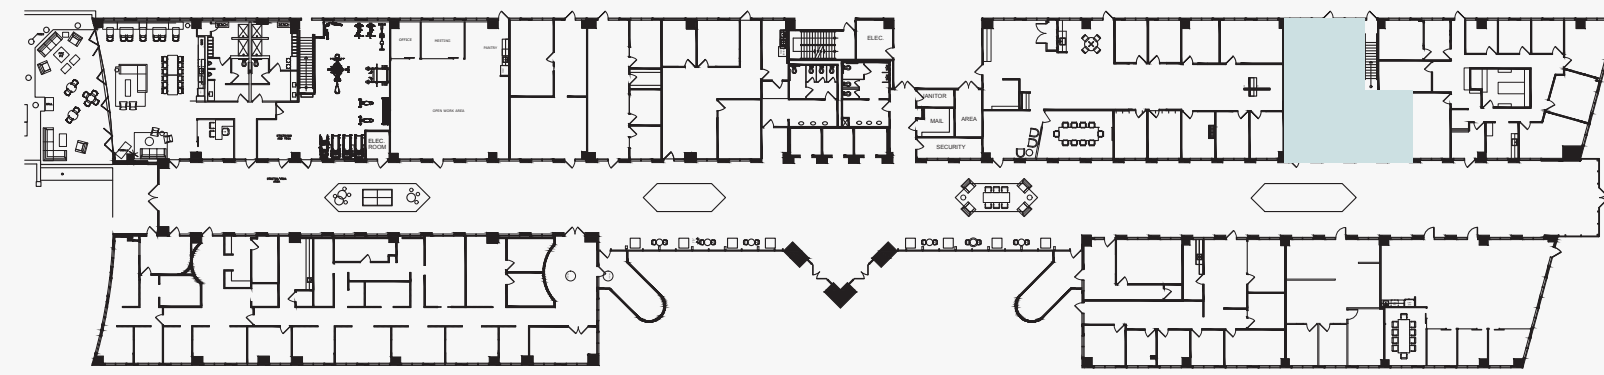

For leasing information please contact:

Josh Bernstein
310.228.1425
josh.bernstein@cushwake.com

Scott Menkus
310.595.2211
scott.menkus@cushwake.com

Pete Collins
310.595.2227
pete.collins@cushwake.com

