

SUITE: 160



RSF: 1,769

AS-BUILT CONFIGURATION

OFFICES.....	3
RECEPTION.....	1
CONFERENCE ROOMS.....	1
KITCHEN/BREAKOUT	1

KEY PLAN

Not to scale, furniture and appliances not included

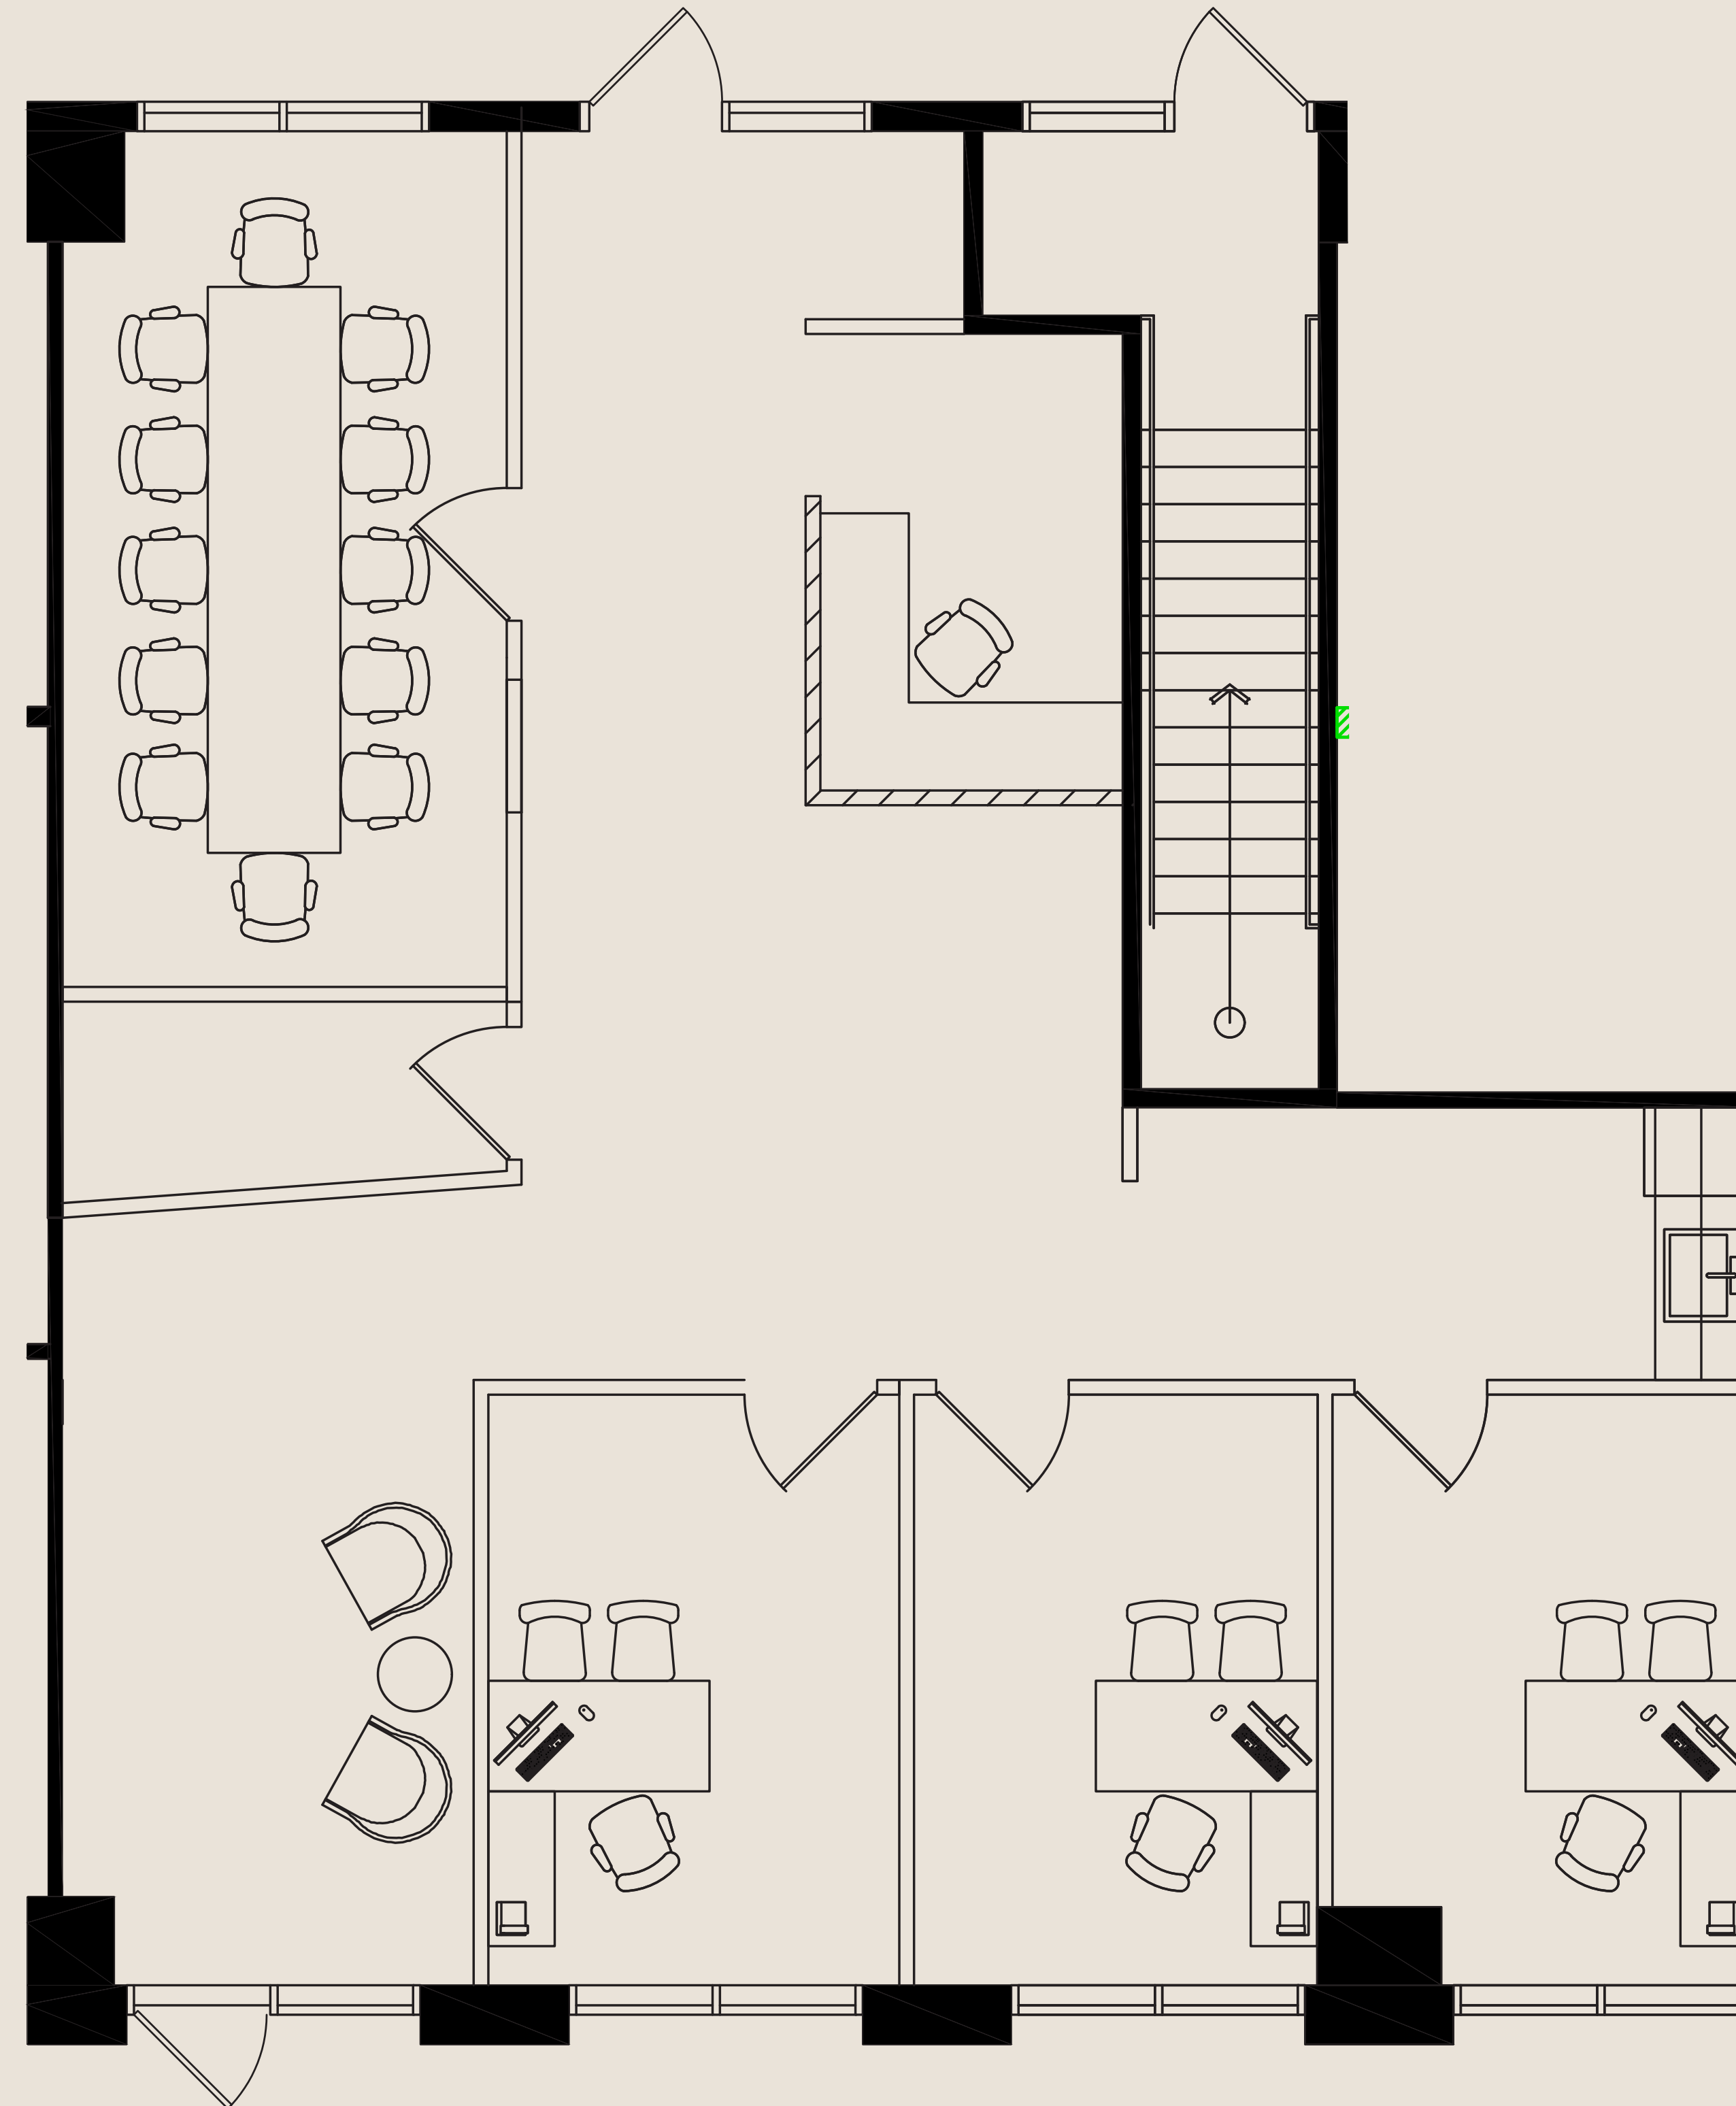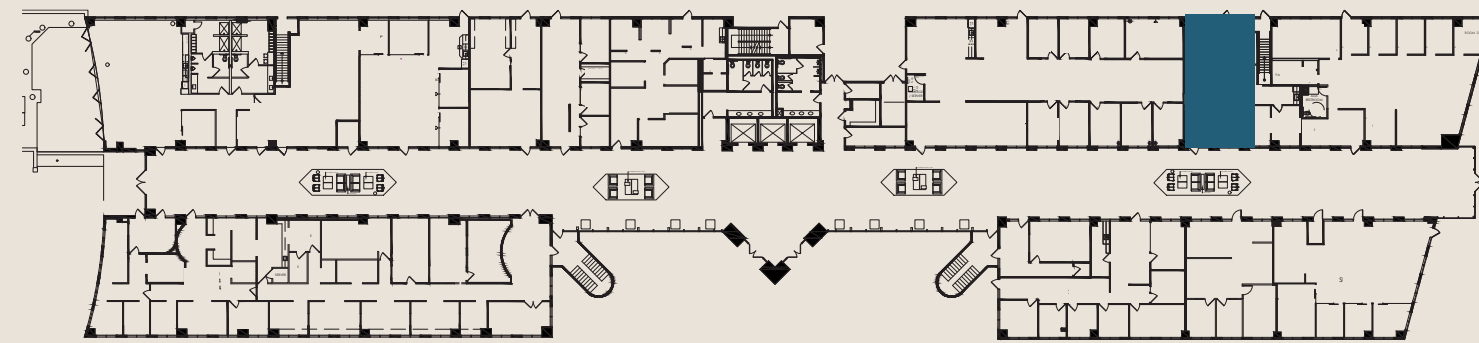

For leasing information please contact:
USALEASING@ONNI.COM
(213) 629 - 2041