

SUITE: 170

RSF: 2,467




AS-BUILT CONFIGURATION

- PRIVATE OFFICES.....3
- CONFERENCE ROOMS.....2
- PANTRY.....1

KEY PLAN

Not to scale, furniture and appliances not included

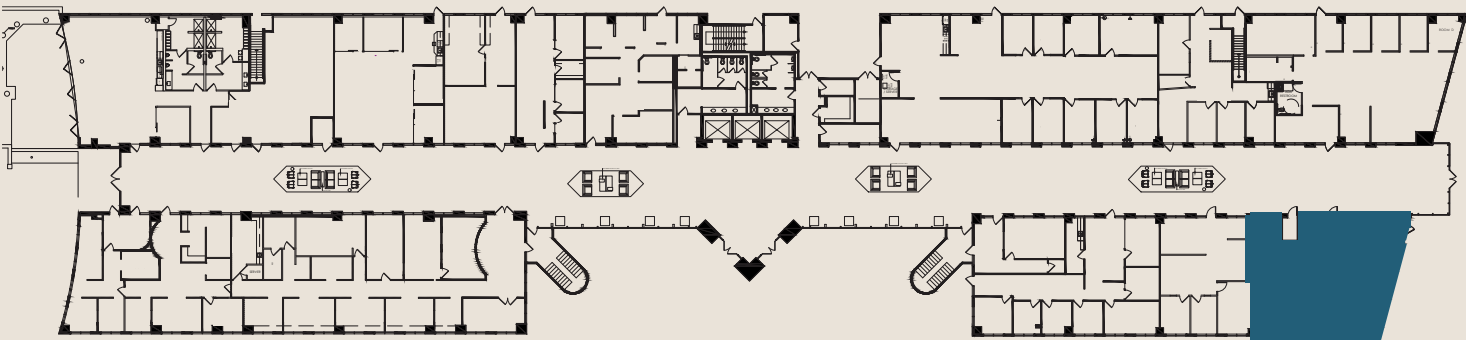

For leasing information please contact:
USALEASING@ONNI.COM
(213) 629 - 2041

