
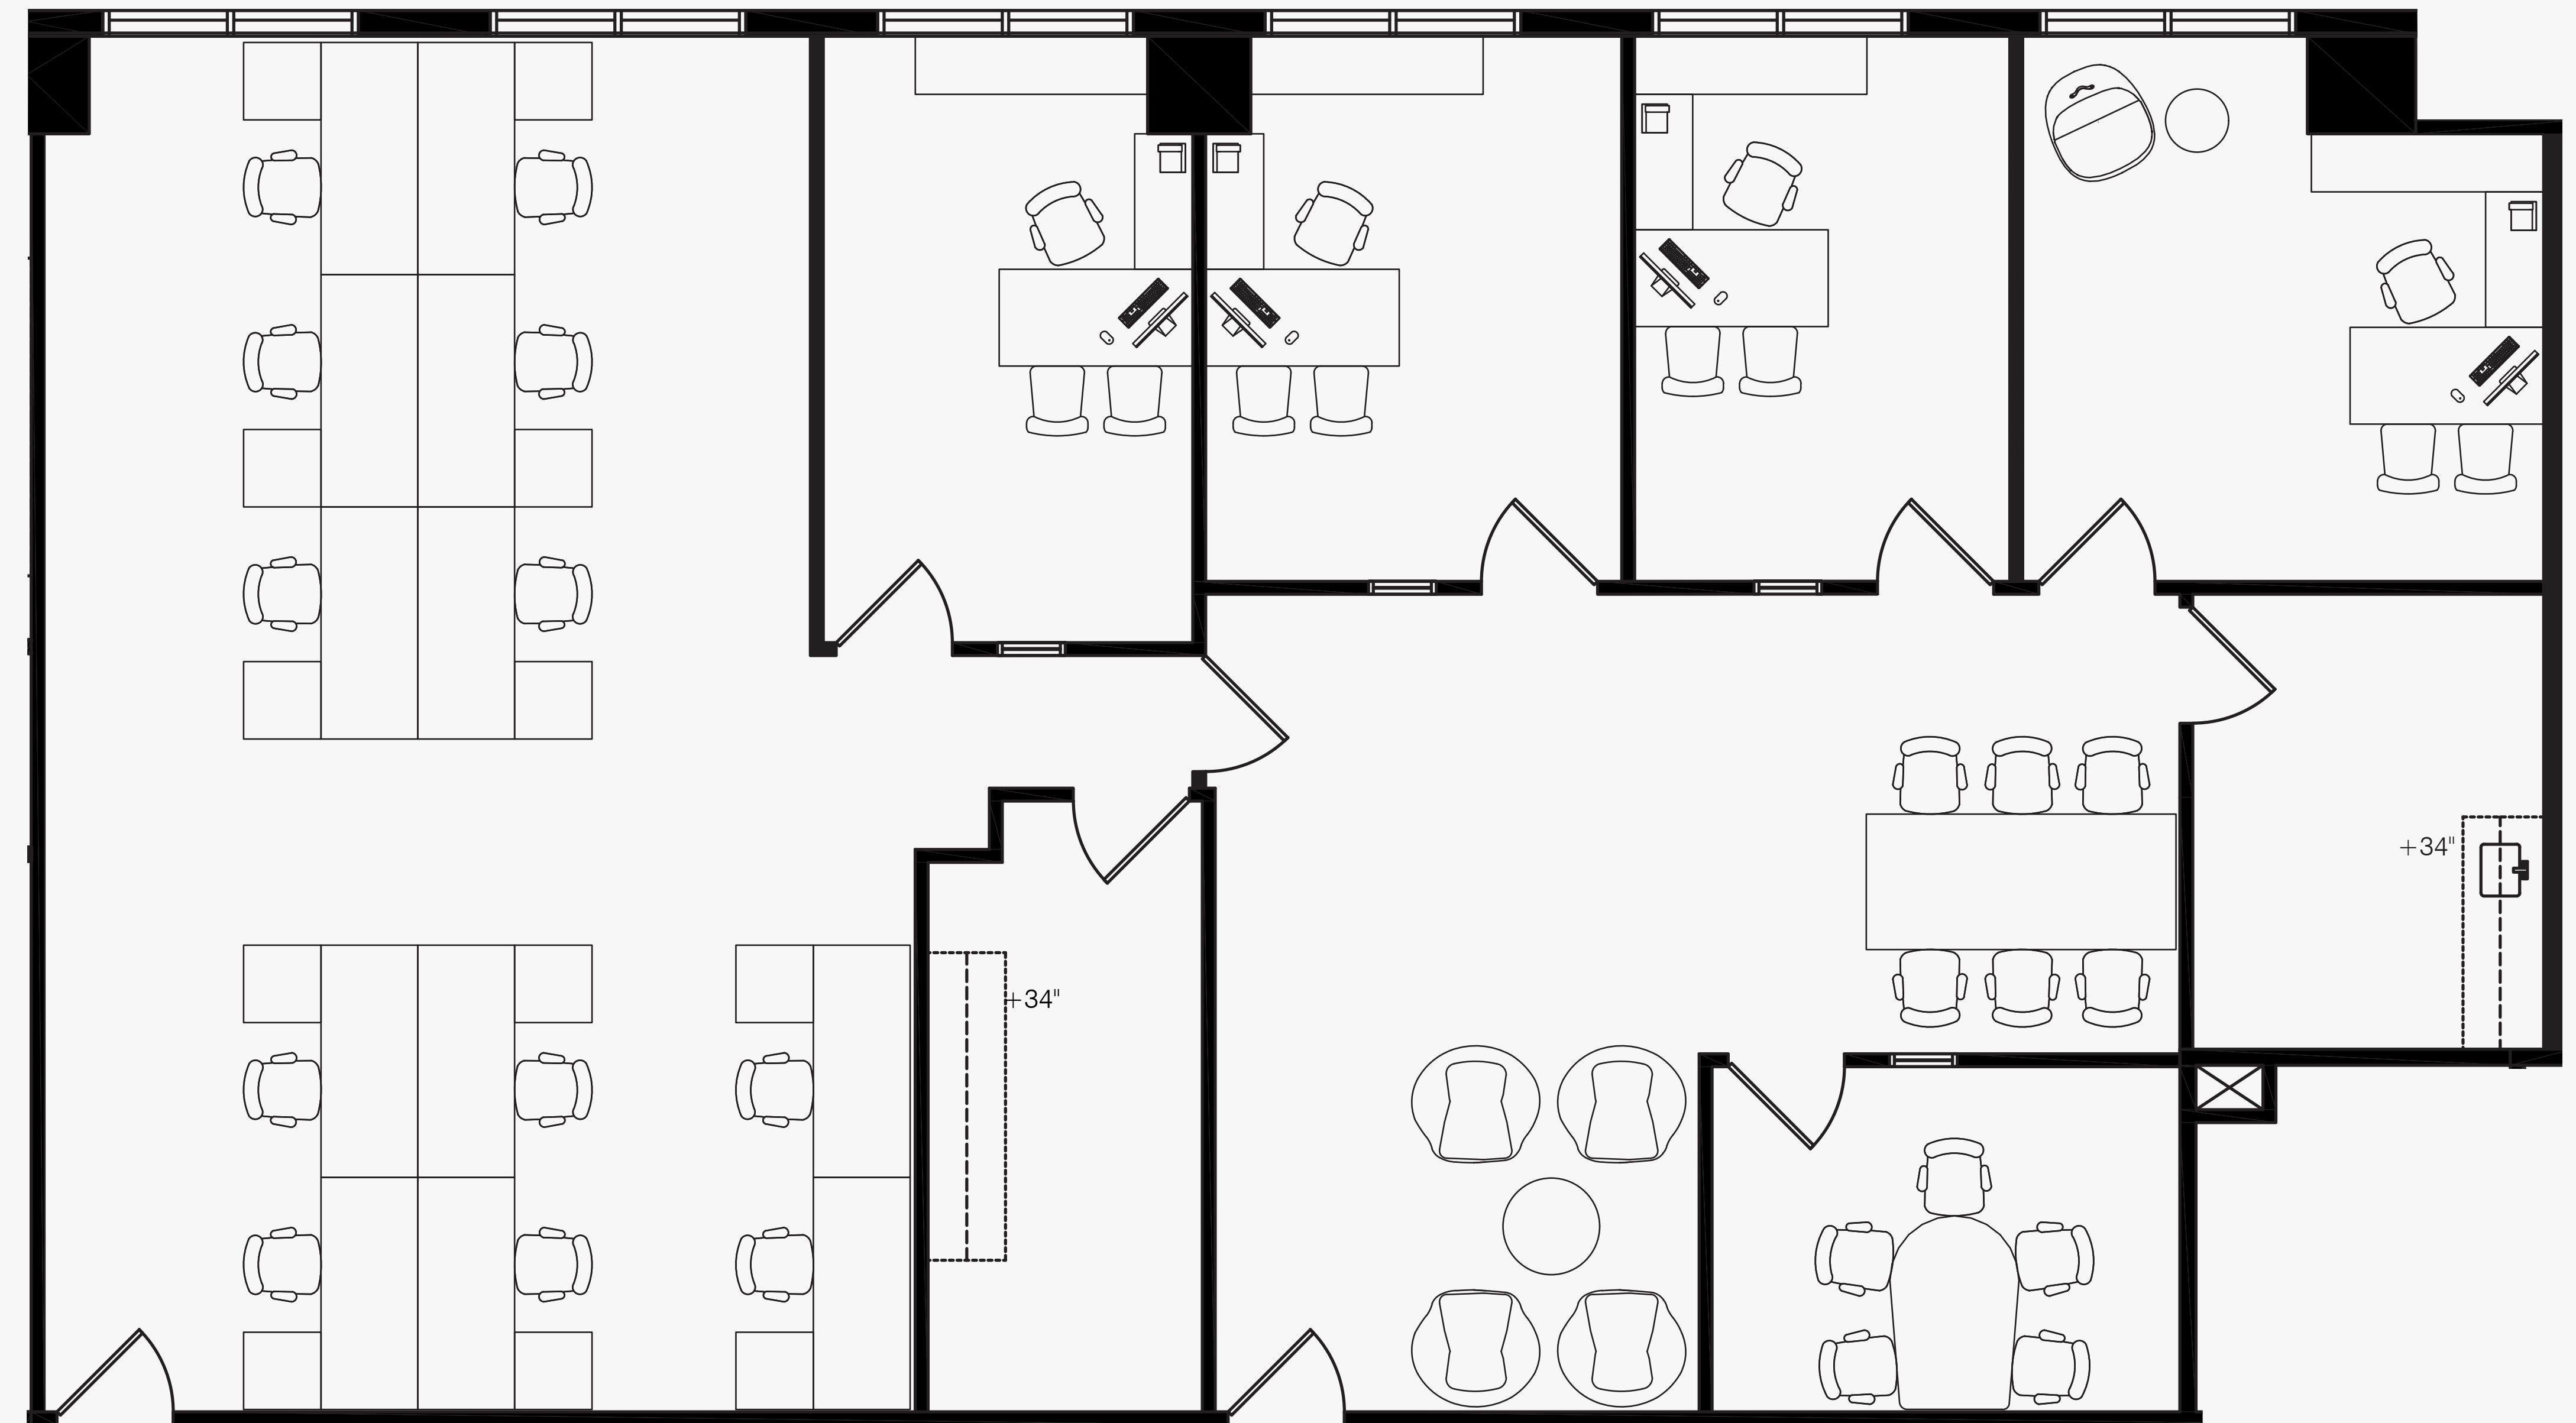


AS-BUILT CONFIGURATION

- OFFICES..... 4
- RECEPTION..... 1
- CONFERENCE ROOMS..... 1
- KITCHEN/BREAKOUT 2
- OPEN WORK AREA..... +/- 12

KEY PLAN

(FURNITURE AND APPLIANCES NOT INCLUDED)

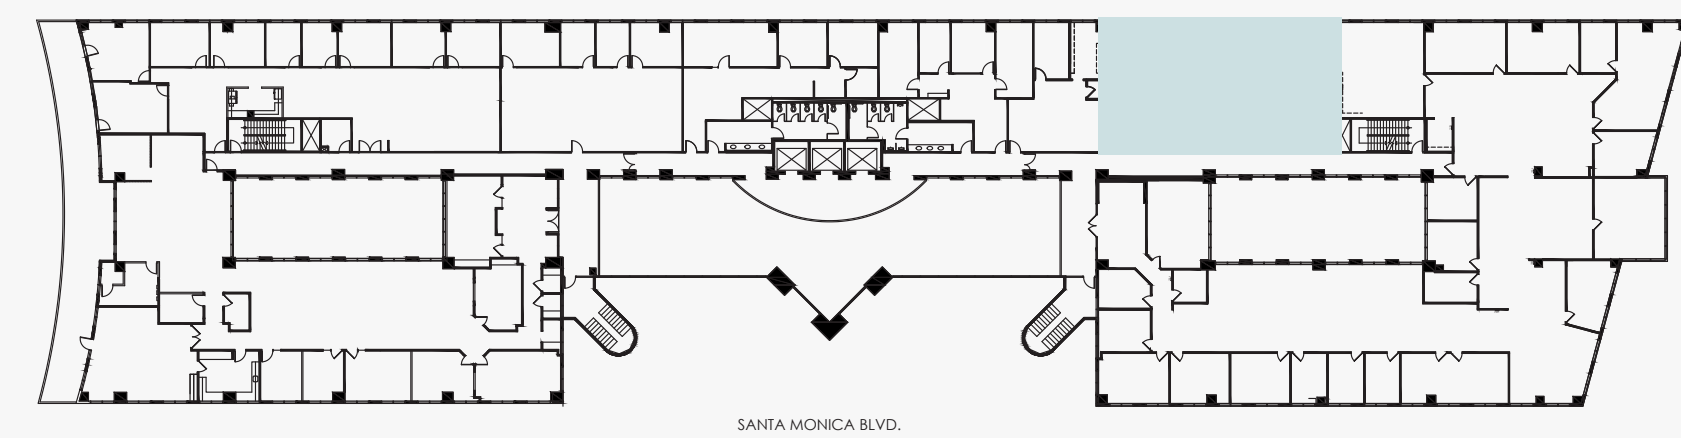

For leasing information please contact:

Josh Bernstein
310.228.1425
josh.bernstein@cushwake.com

Scott Menkus
310.595.2211
scott.menkus@cushwake.com

Pete Collins
310.595.2227
pete.collins@cushwake.com