

# SUITE: 315

# RSF: 1,049



# ATRIA WEST

## AS-BUILT CONFIGURATION

- OFFICES..... 1
- RECEPTION..... 1
- CONFERENCE ROOMS..... N/A
- KITCHEN/BREAKOUT ..... N/A
- OPEN WORK AREA..... +/- 6

## KEY PLAN

(FURNITURE AND APPLIANCES NOT INCLUDED)

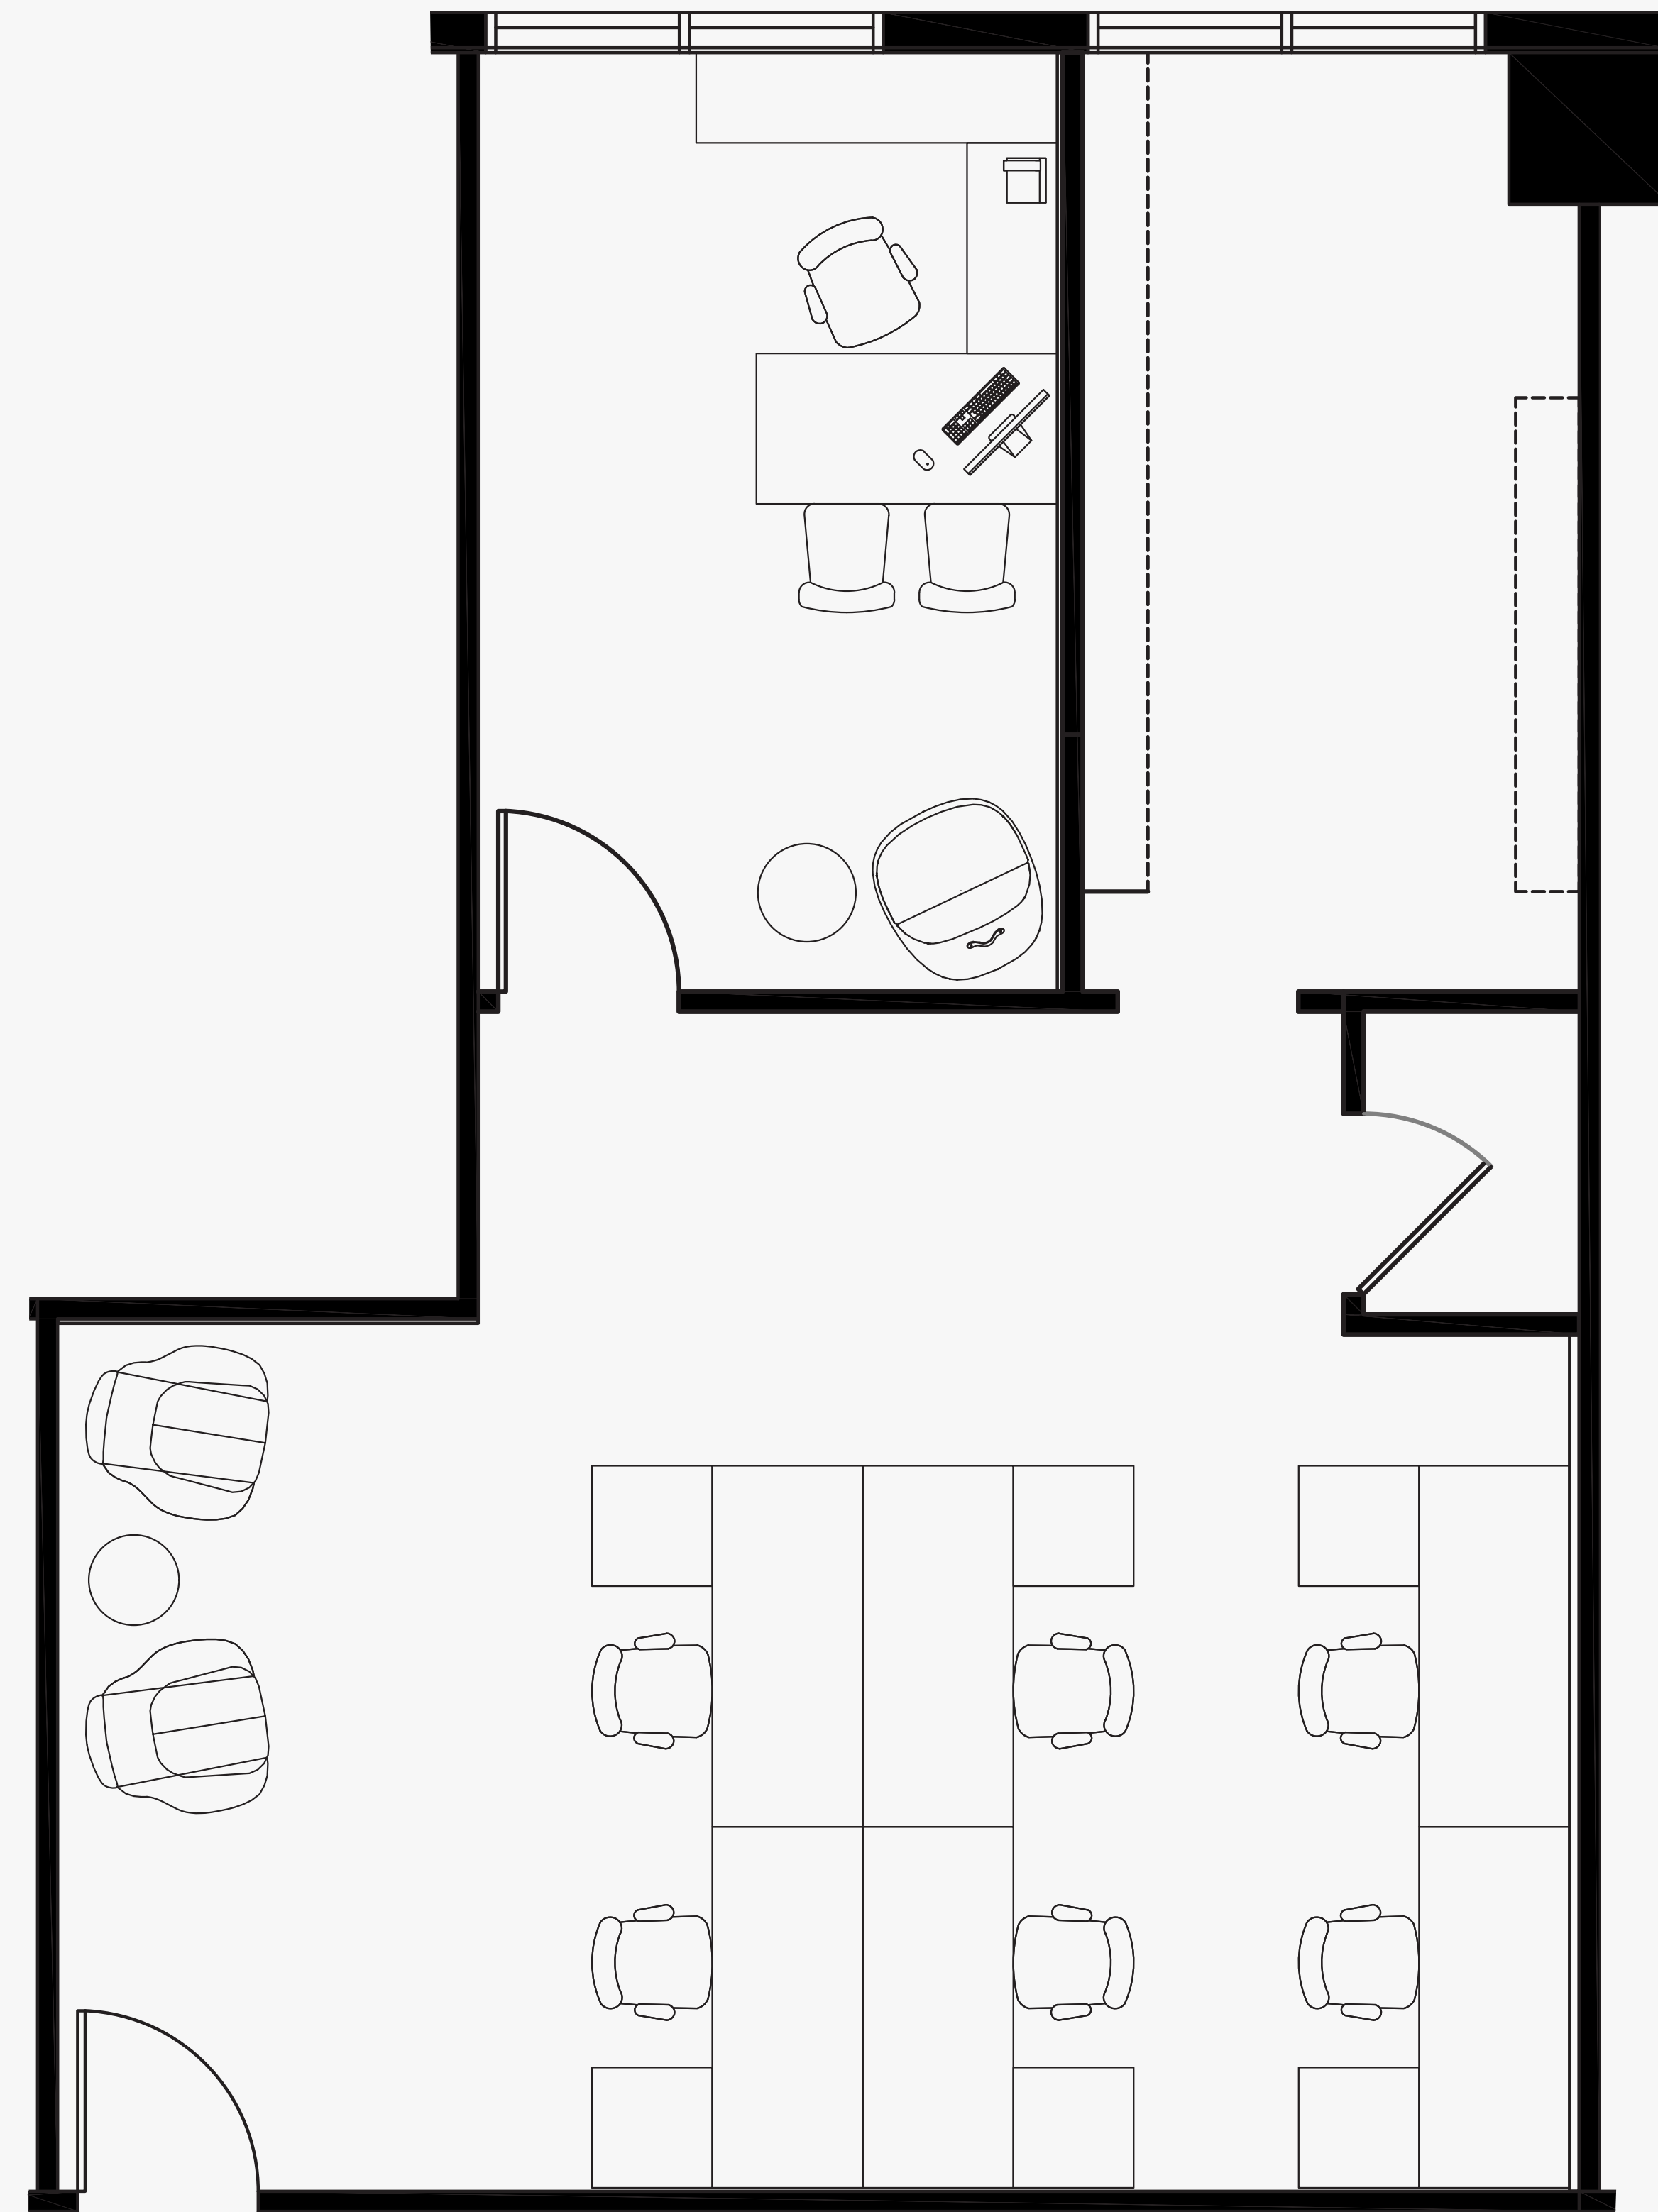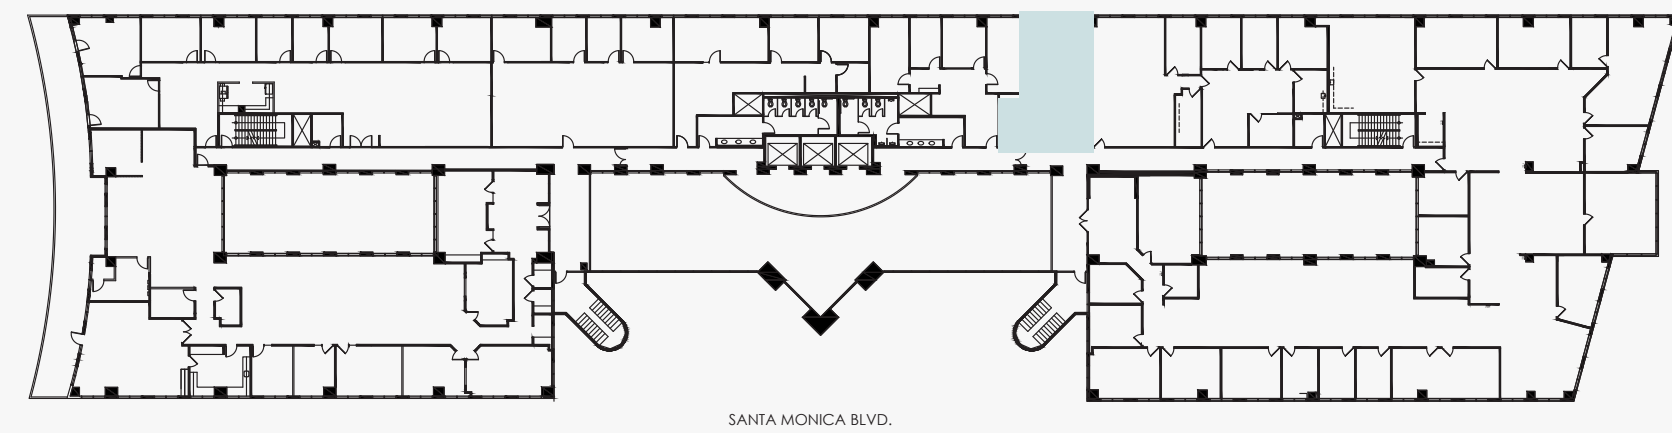

For leasing information please contact:

Josh Bernstein  
310.228.1425  
josh.bernstein@cushwake.com

Scott Menkus  
310.595.2211  
scott.menkus@cushwake.com

Pete Collins  
310.595.2227  
pete.collins@cushwake.com

