

SUITE: 315

RSF: 1,049



AS-BUILT CONFIGURATION

OFFICES..... 1

OPEN WORK AREA..... +/- 6

KEY PLAN

*Not to scale, furniture and appliances not included*

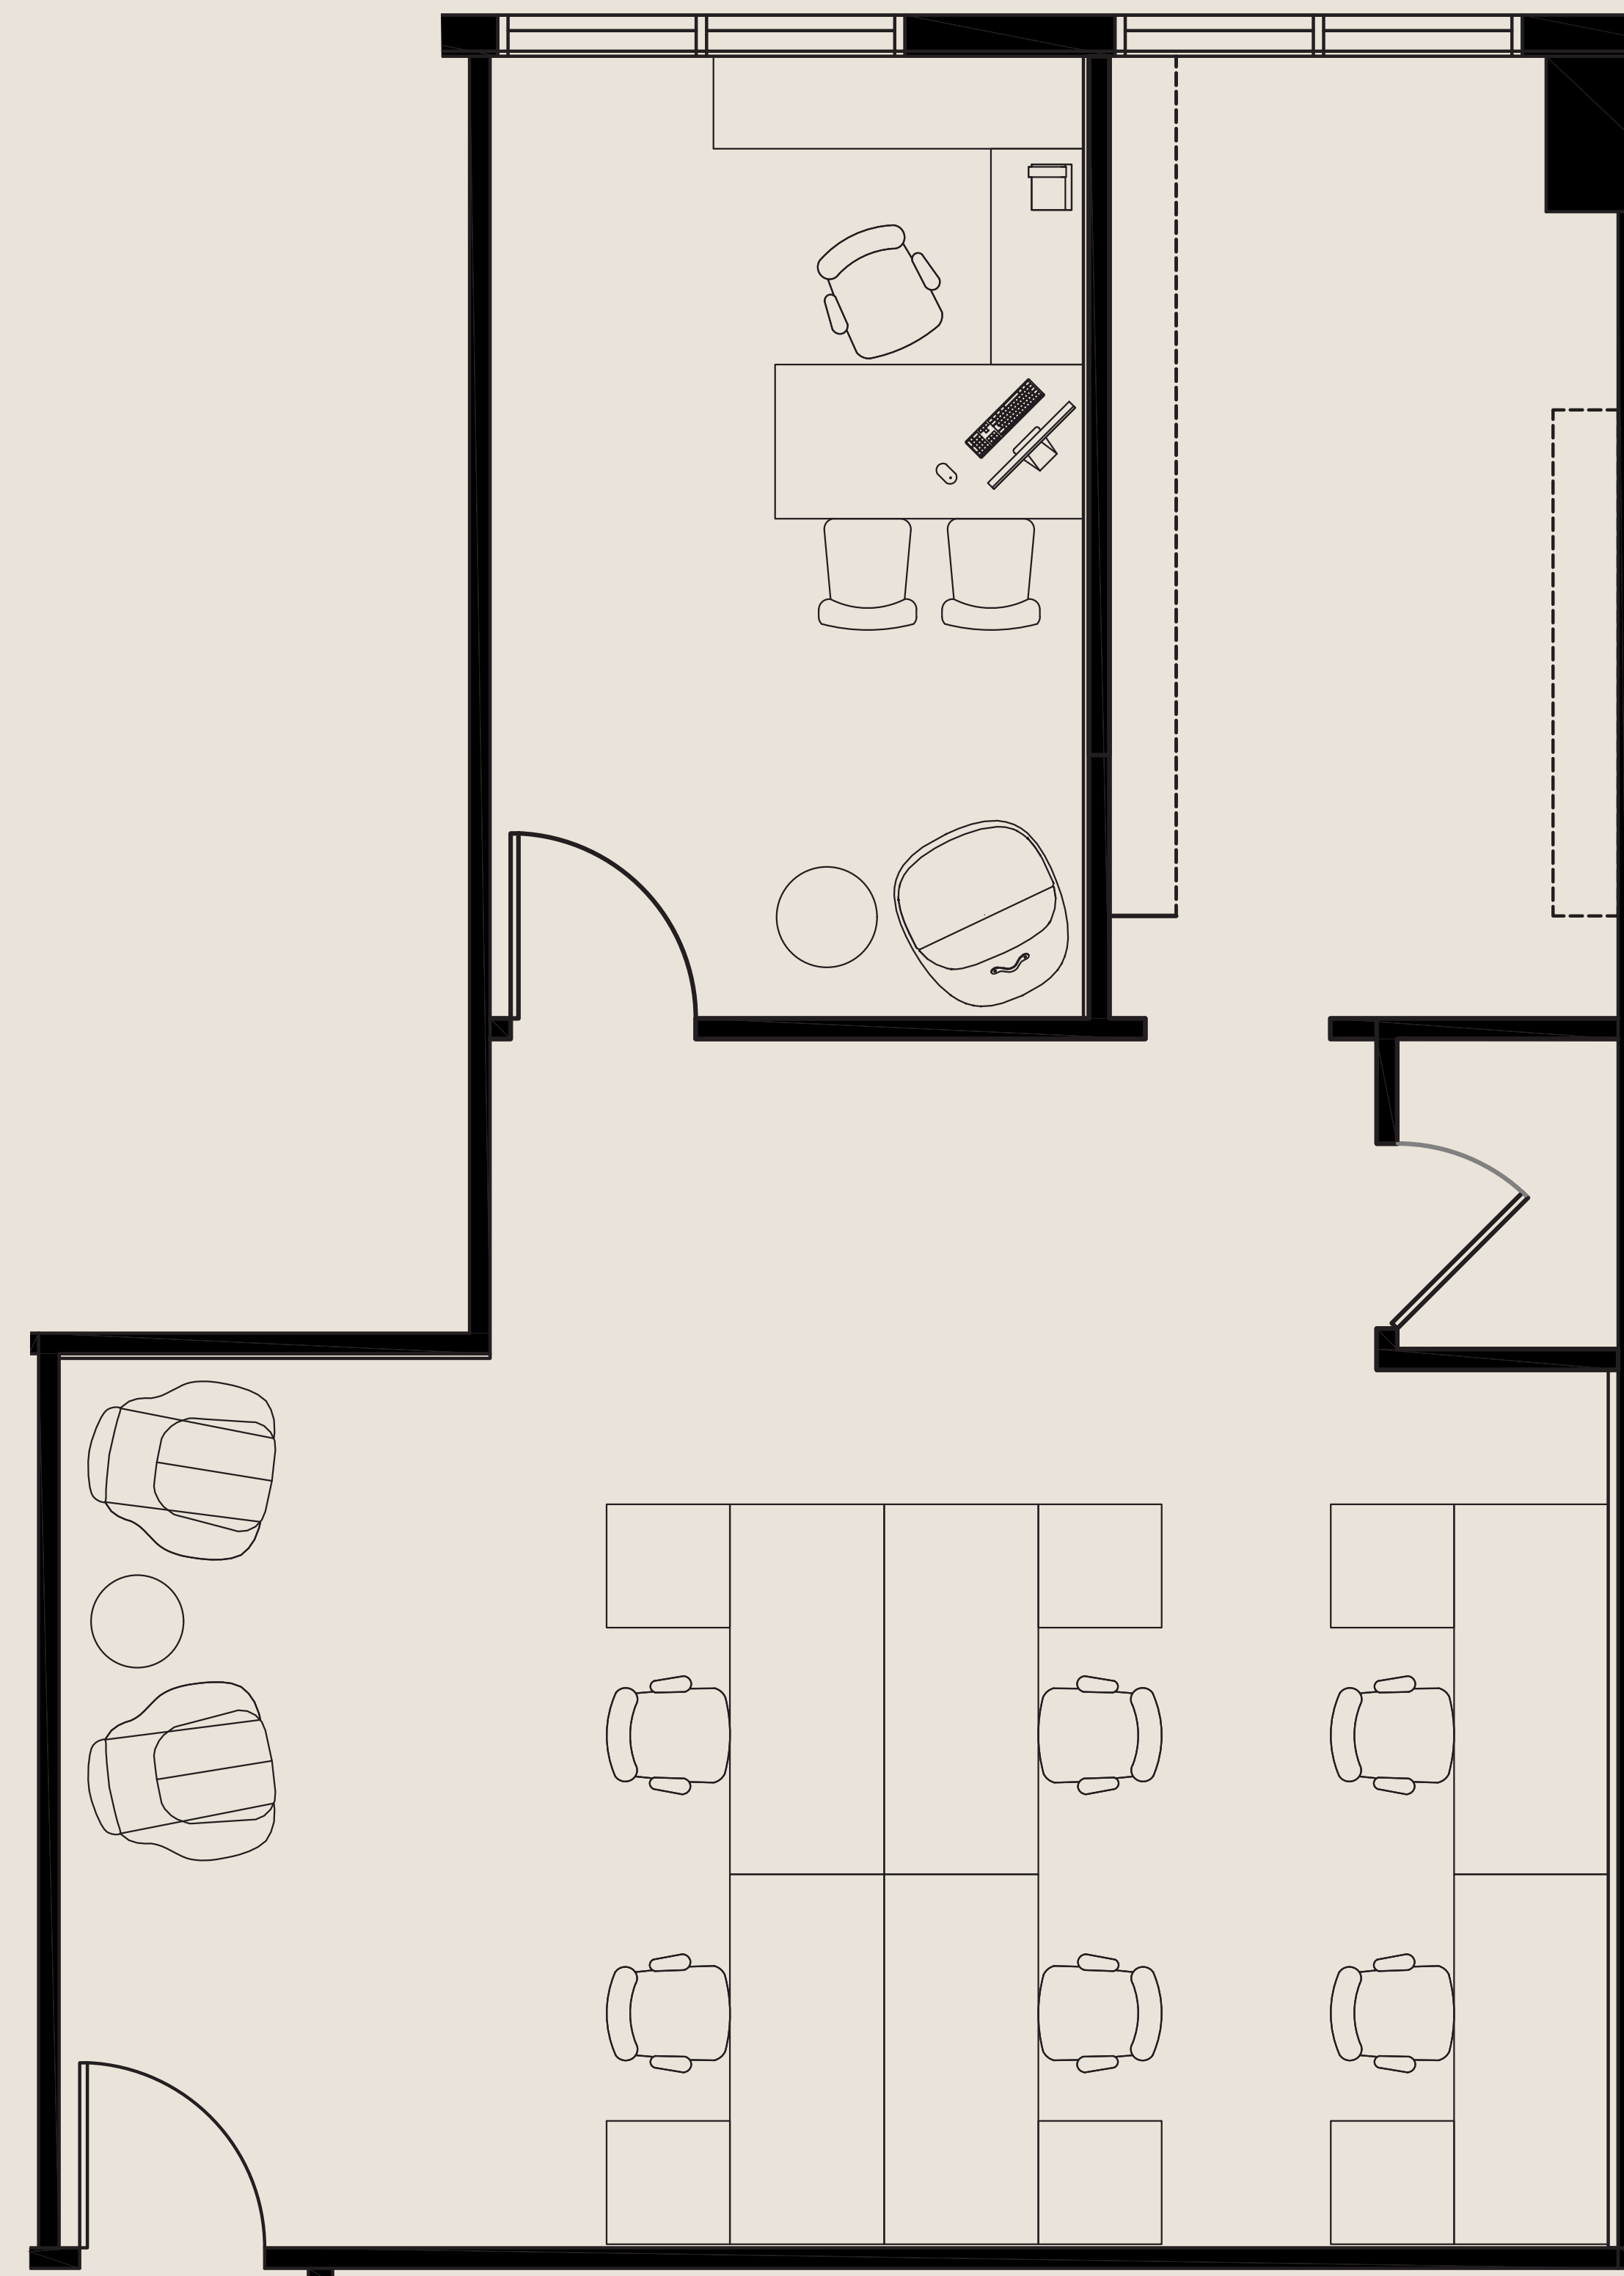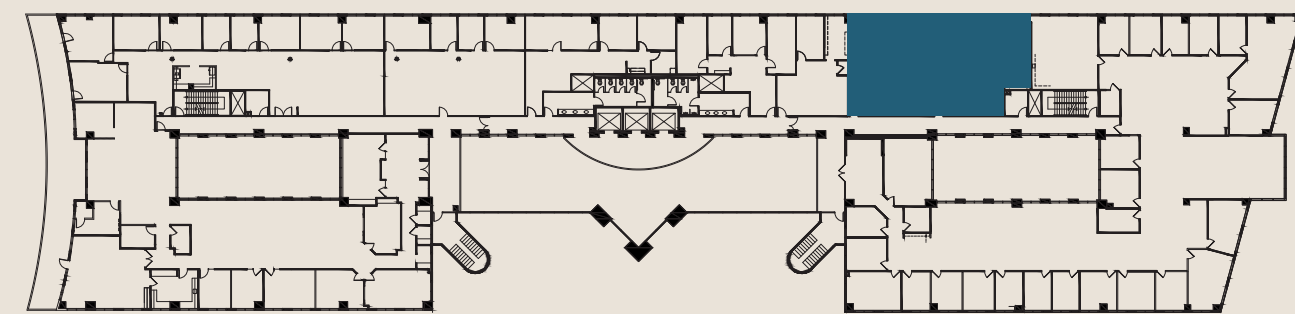

For leasing information please contact:  
USALEASING@ONNI.COM  
(213) 629 - 2041