

SUITE: 340



RSF: 1,742

AS-BUILT CONFIGURATION

- OFFICES.....2
- CONFERENCE ROOMS.....1
- OPEN WORK AREA.....+/-3

KEY PLAN

Not to scale, furniture and appliances not included

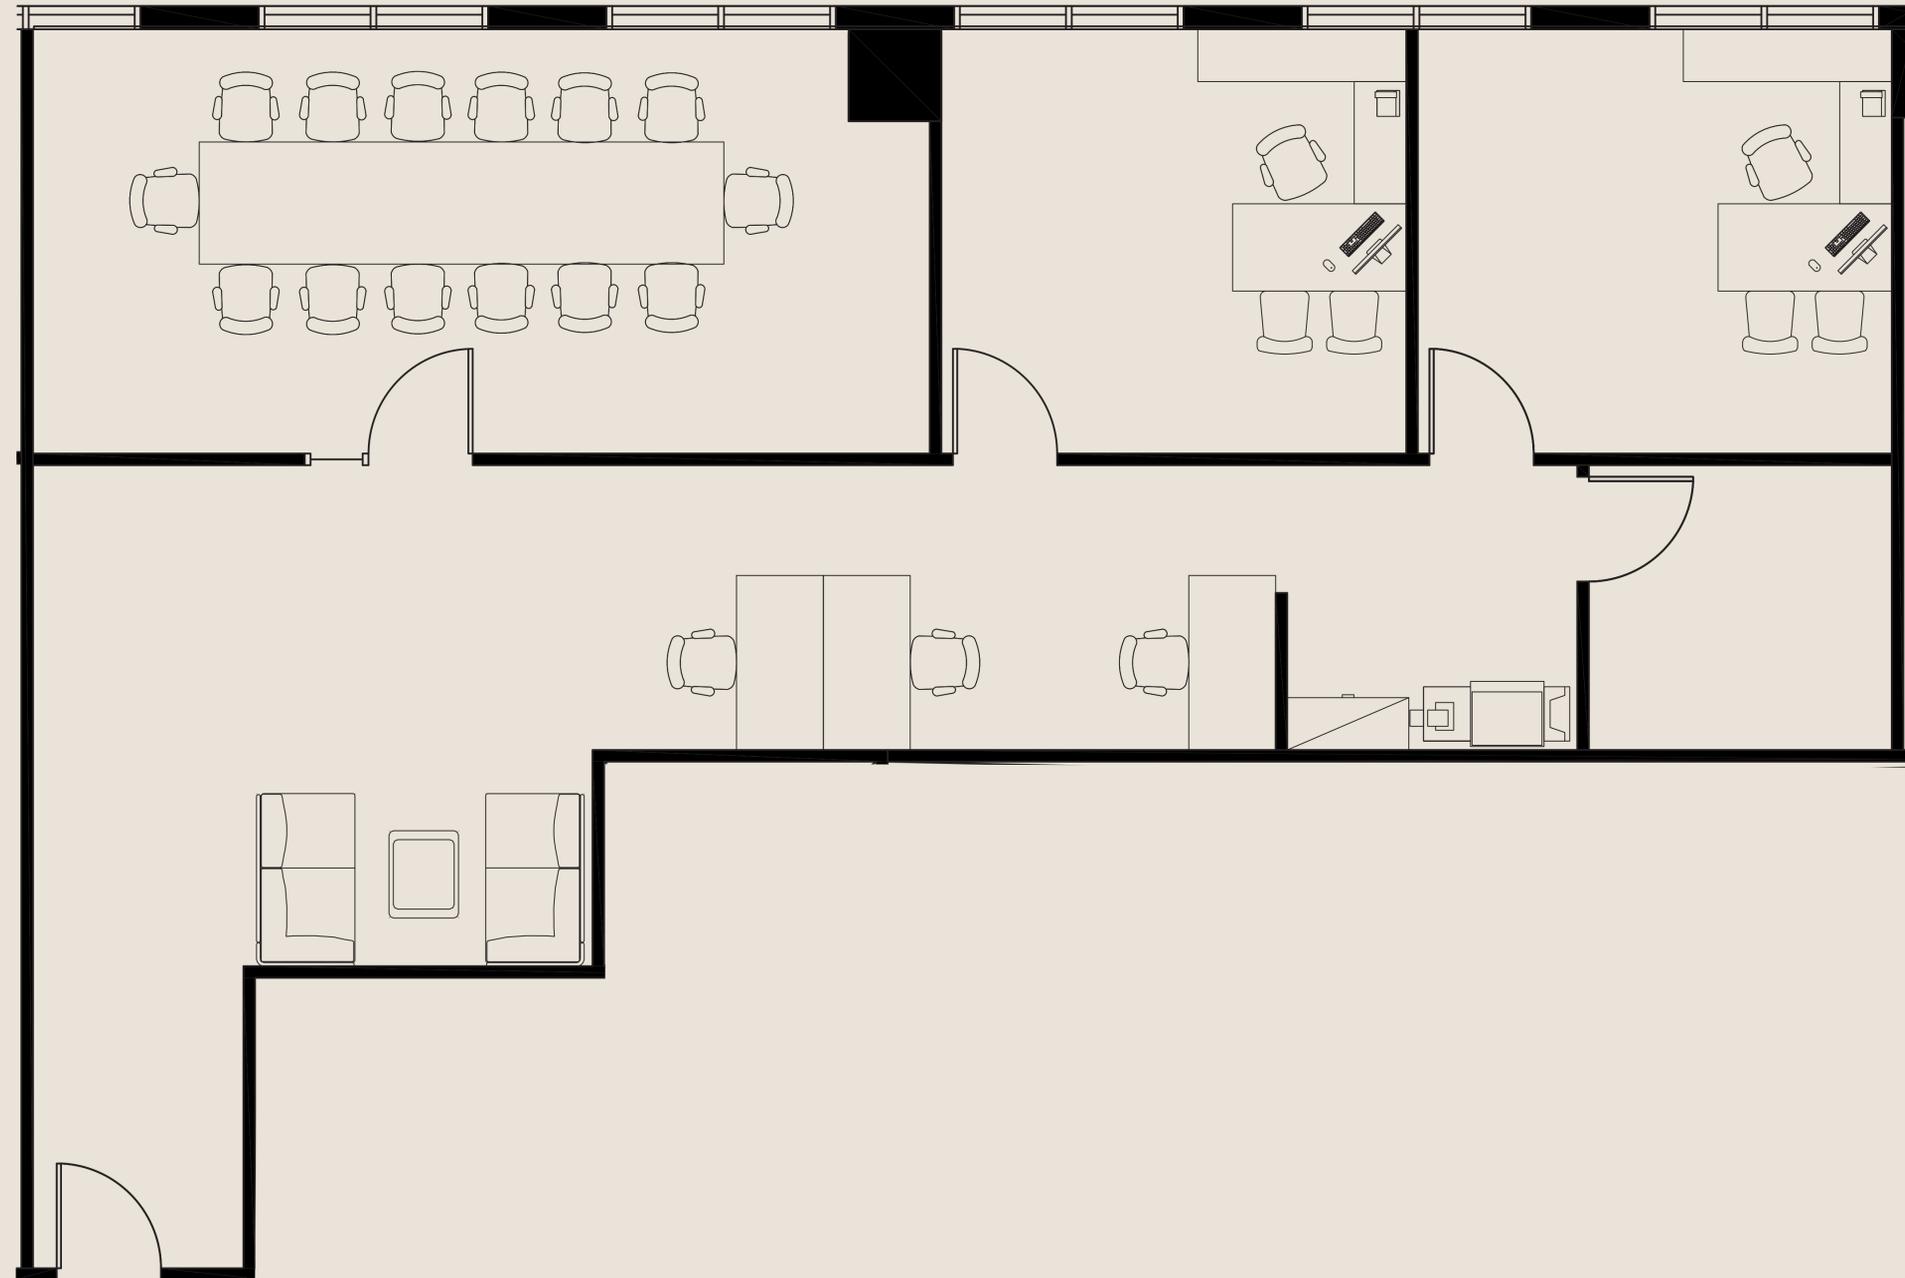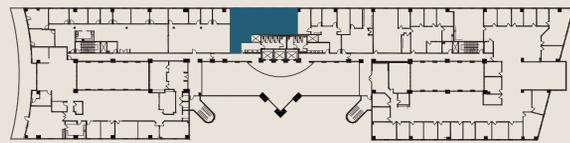

For leasing information please contact:
USALEASING@ONNI.COM
(213) 629 - 2041