

SUITE: 340

RSF: 1,742



# ATRIA WEST

## AS-BUILT CONFIGURATION

- OFFICES..... 2
- RECEPTION..... 1
- CONFERENCE ROOMS..... 1
- KITCHEN/BREAKOUT ..... N/A
- OPEN WORK AREA..... +/- 3

## KEY PLAN

(FURNITURE AND APPLIANCES NOT INCLUDED)

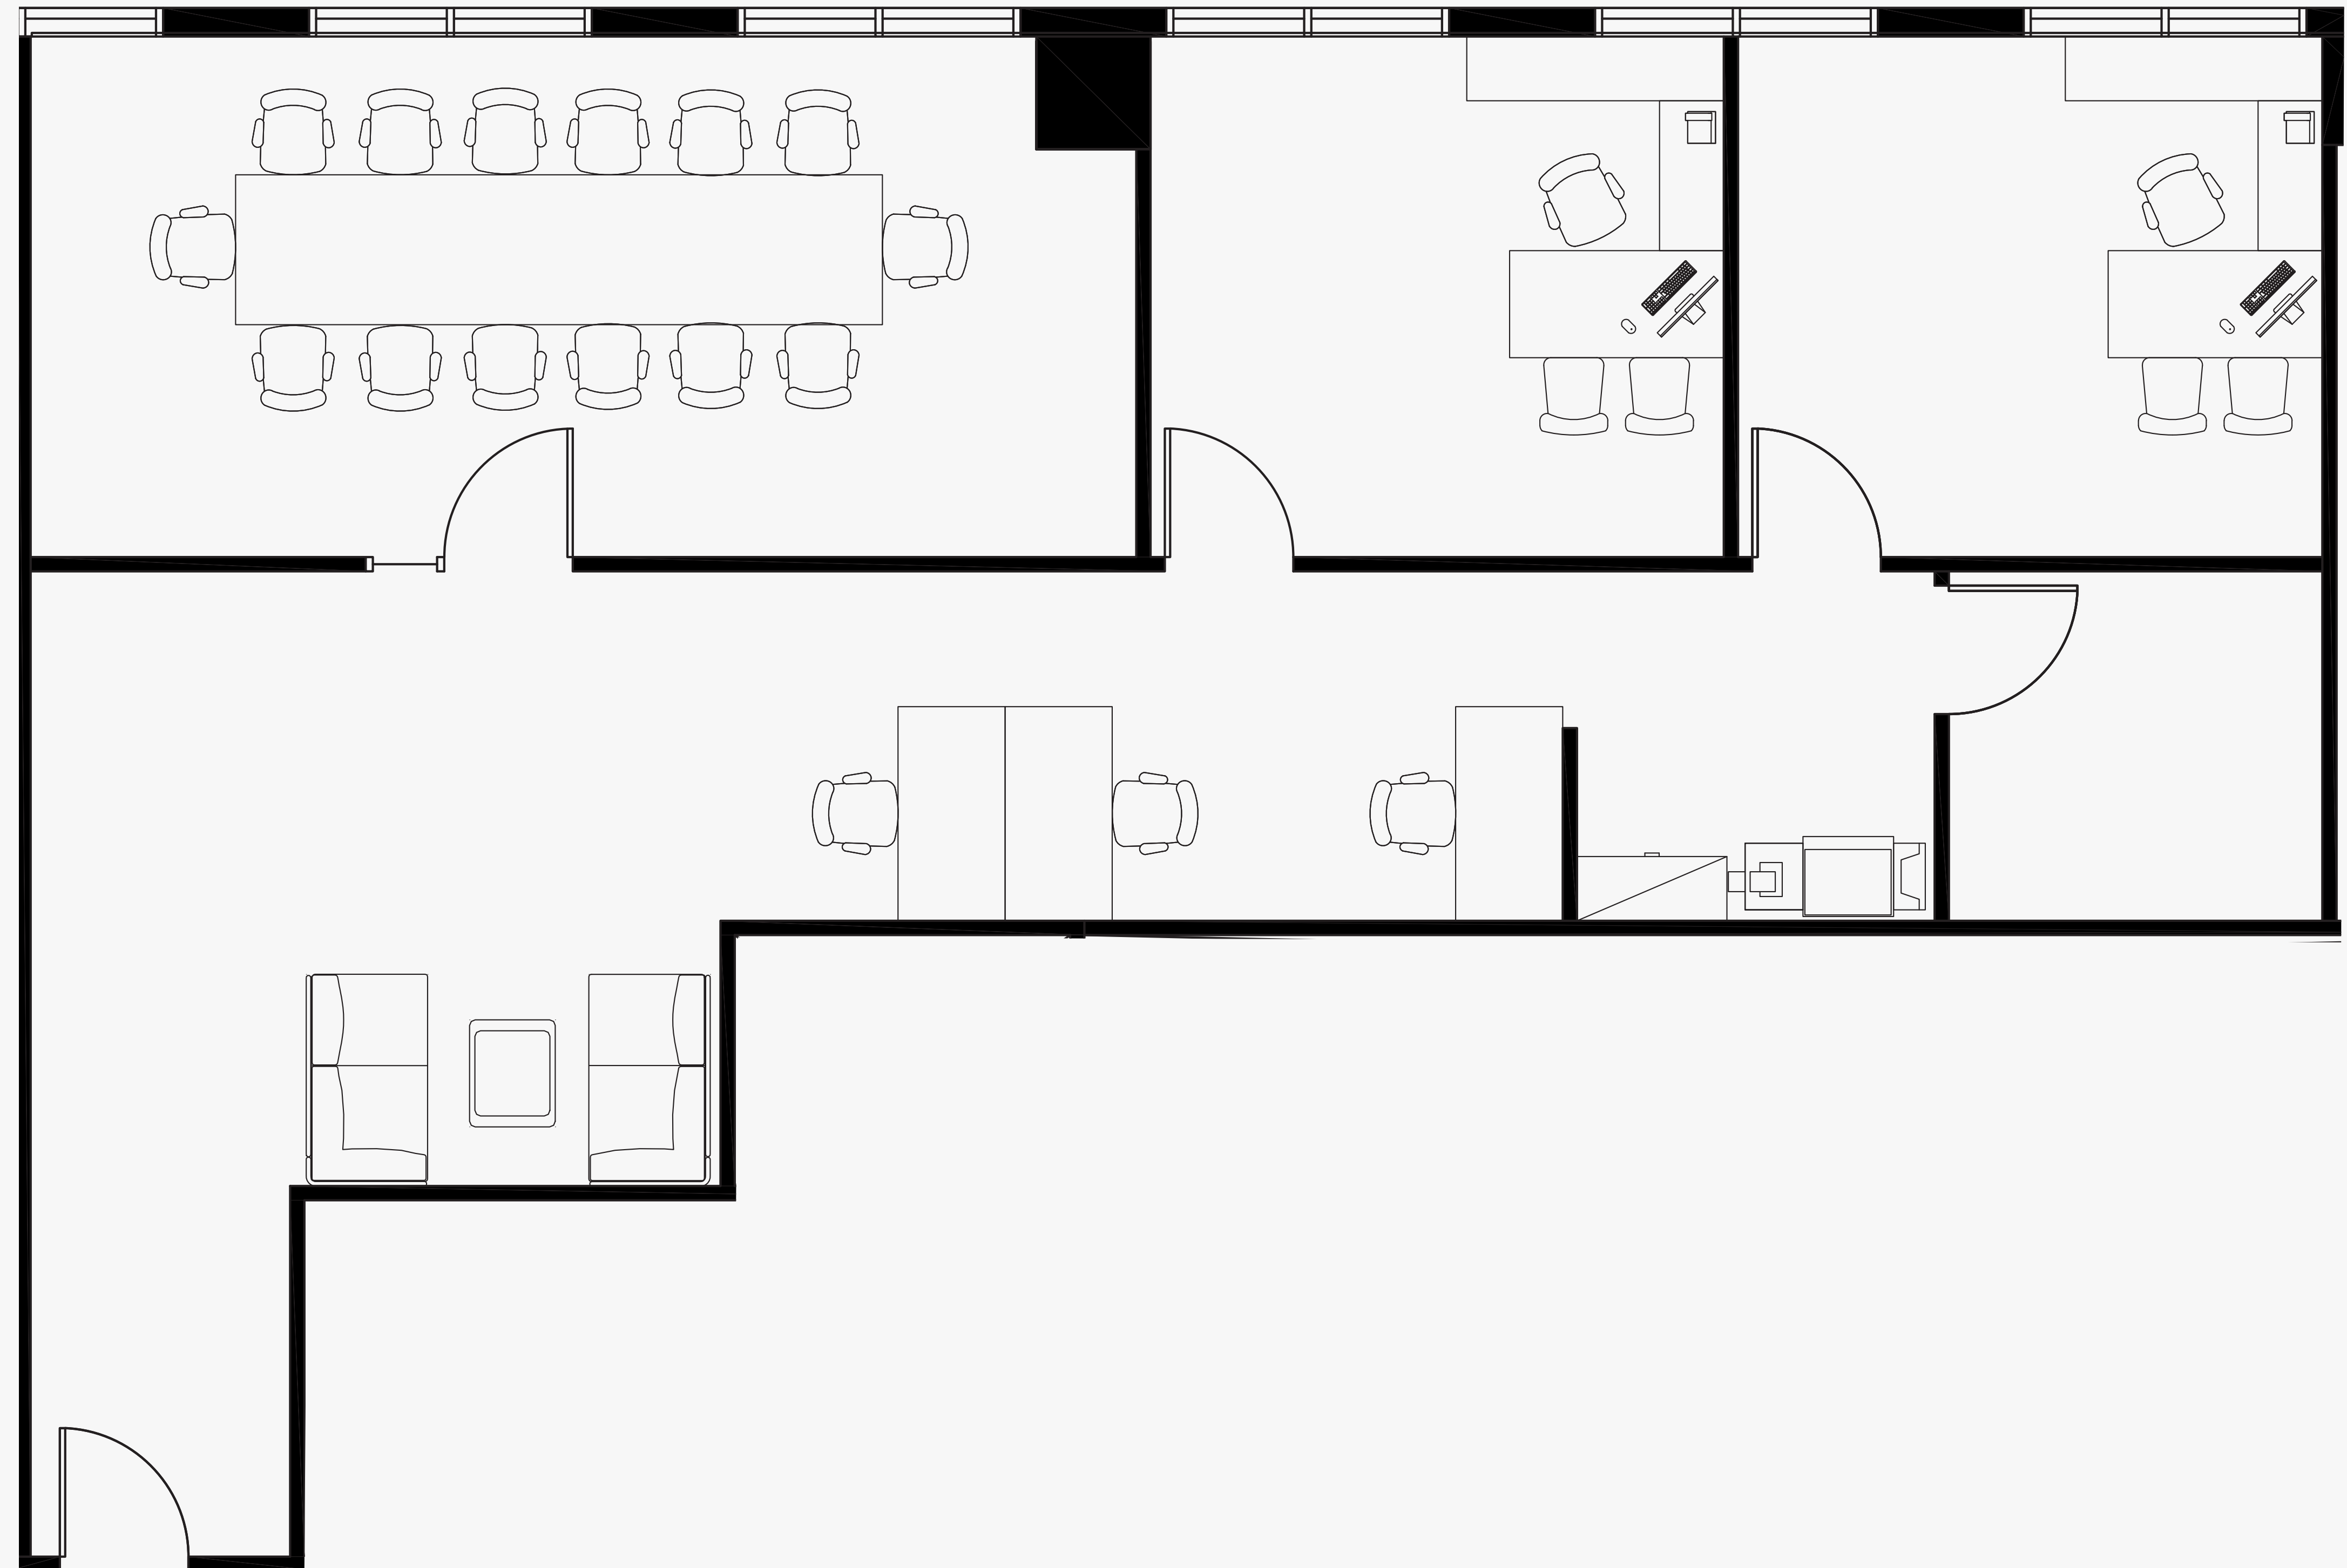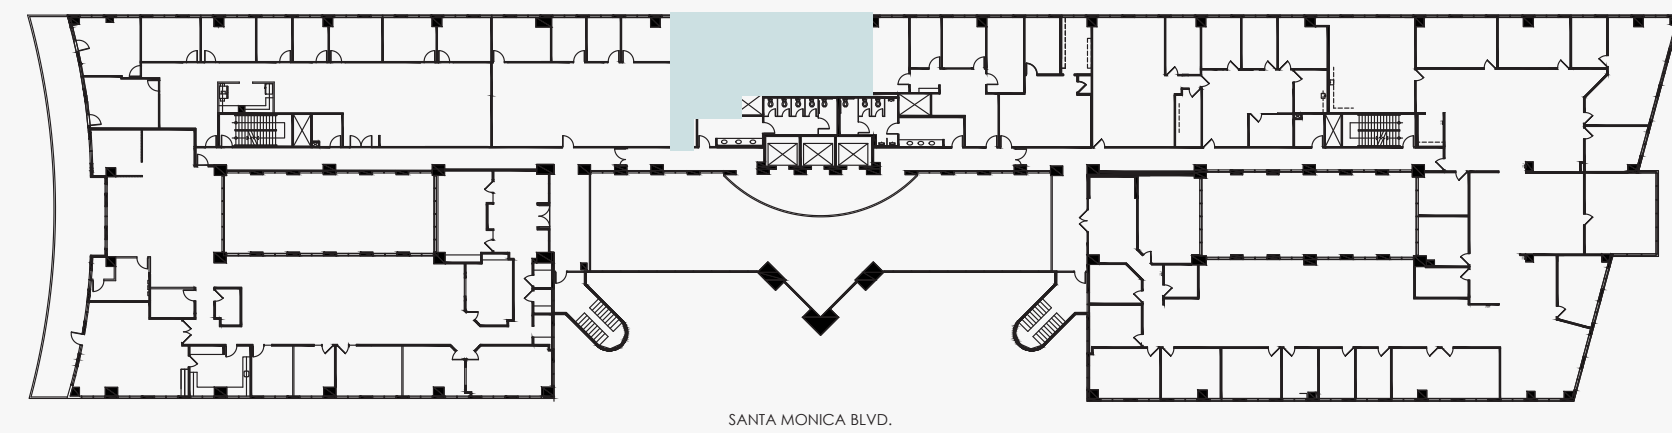

For leasing information please contact:

Josh Bernstein

310.228.1425

josh.bernstein@cushwake.com

Scott Menkus

310.595.2211

scott.menkus@cushwake.com

Pete Collins

310.595.2227

pete.collins@cushwake.com

