



AS-BUILT CONFIGURATION

OFFICES.....	2
RECEPTION.....	1
CONFERENCE ROOMS.....	1
KITCHEN/BREAKOUT .....	1
OPEN WORK AREA.....	N/A

KEY PLAN

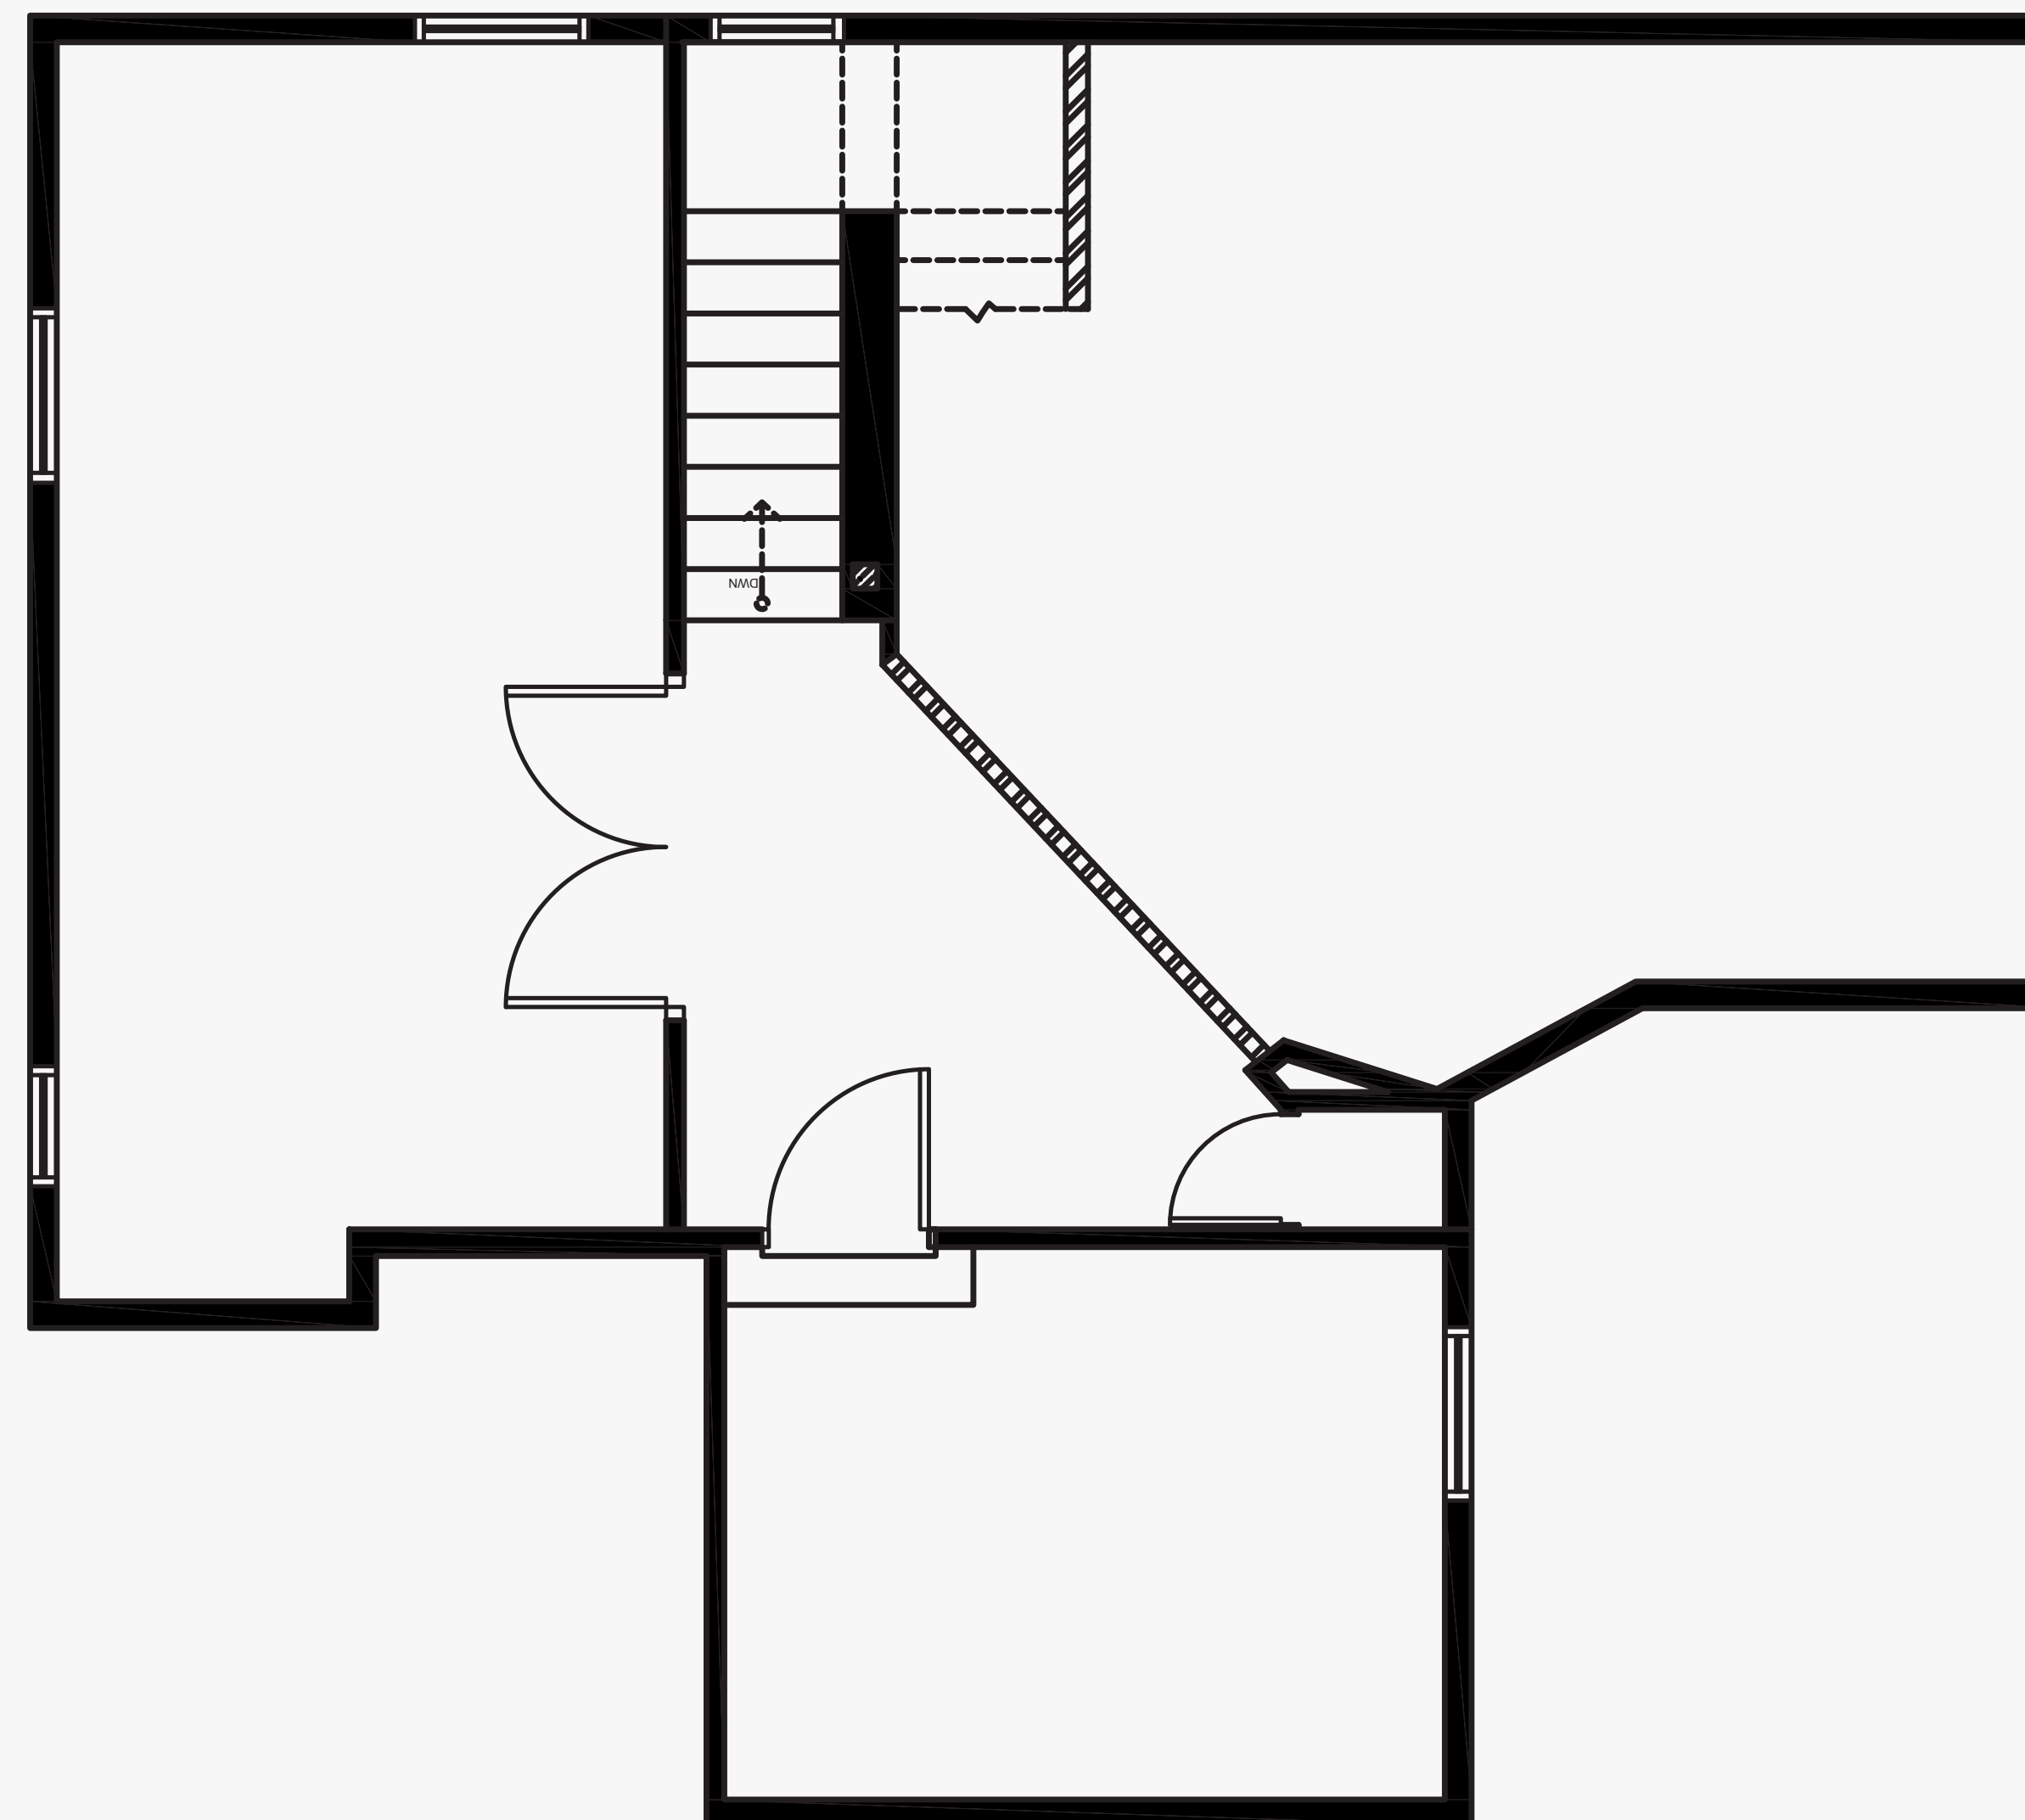

1ST FLOOR

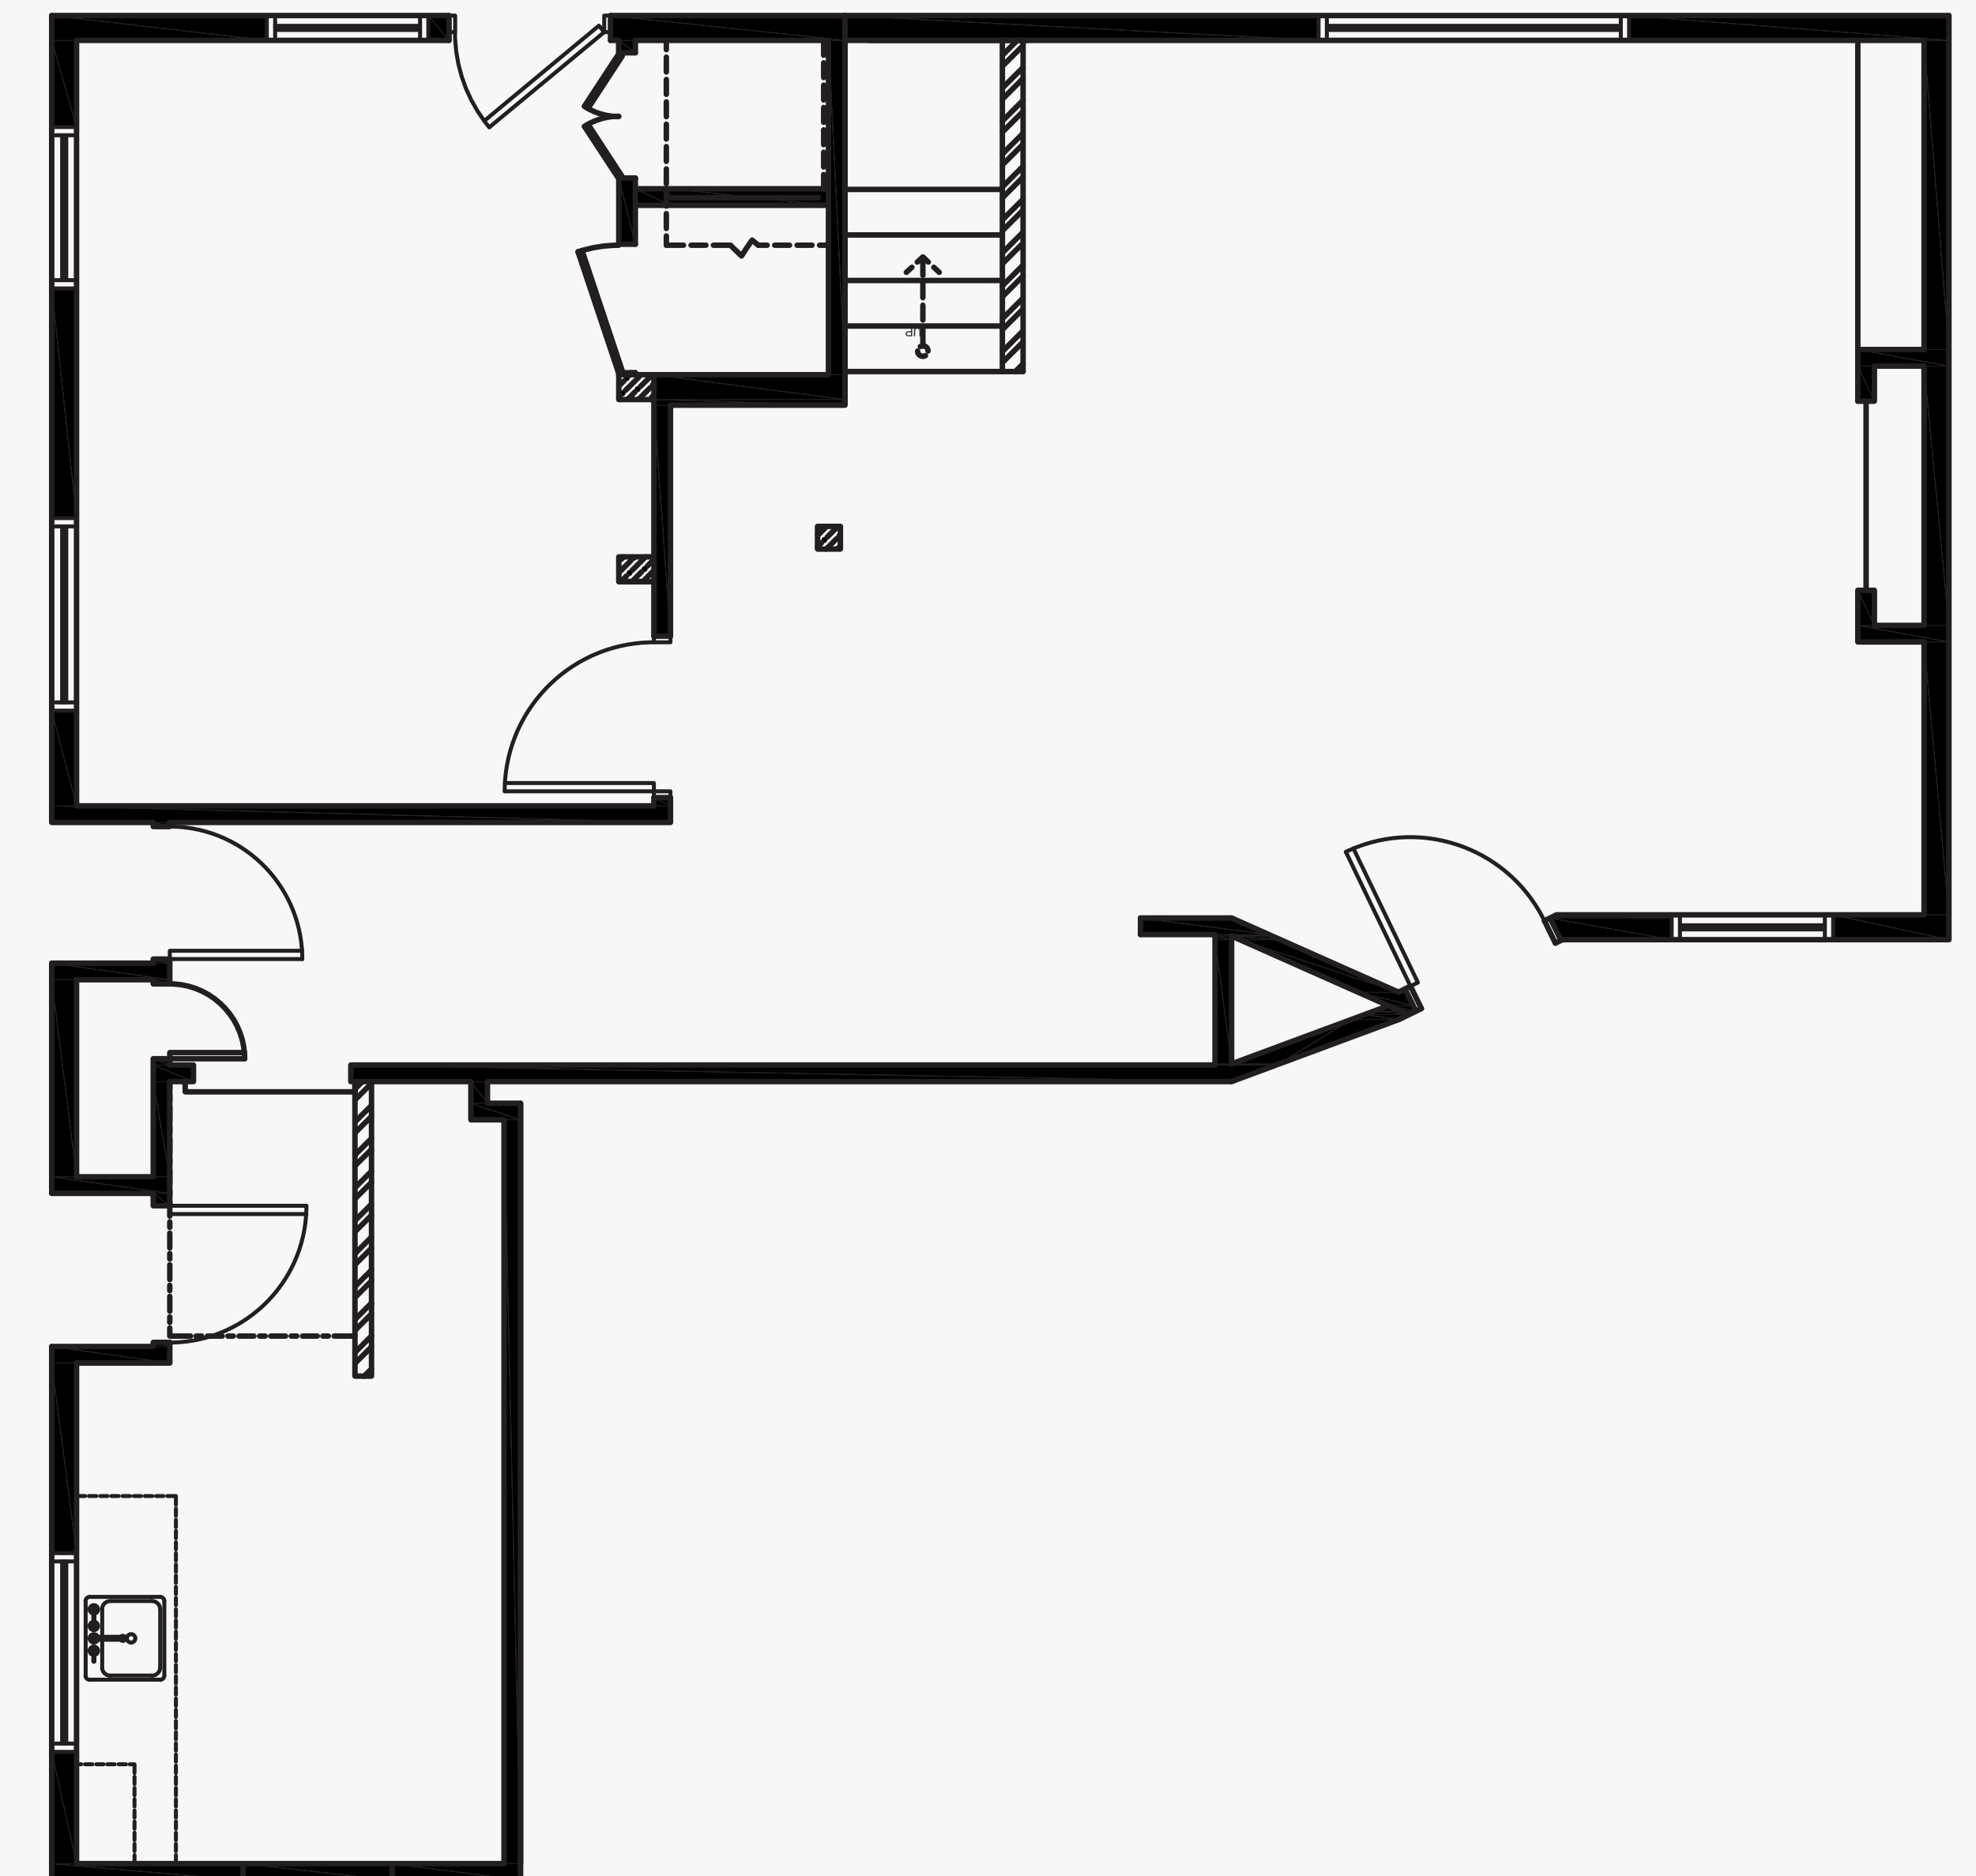

2ND FLOOR

For leasing information please contact:

Josh Bernstein  
310.228.1425  
josh.bernstein@cushwake.com

Scott Menkus  
310.595.2211  
scott.menkus@cushwake.com

Pete Collins  
310.595.2227  
pete.collins@cushwake.com