SUITE: 105 RSF: 1,335

ATRIA WEST

AS-BUILT CONFIGURATION

PRIVATE OFFICES.....2

CONFERENCE ROOMS.....1

OPEN WORK AREA.....+/-4

KEY PLAN

Not to scale, furniture and appliances not included

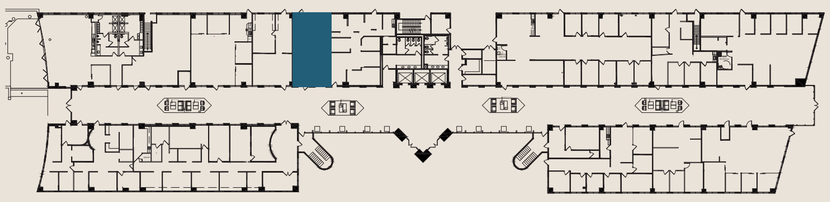

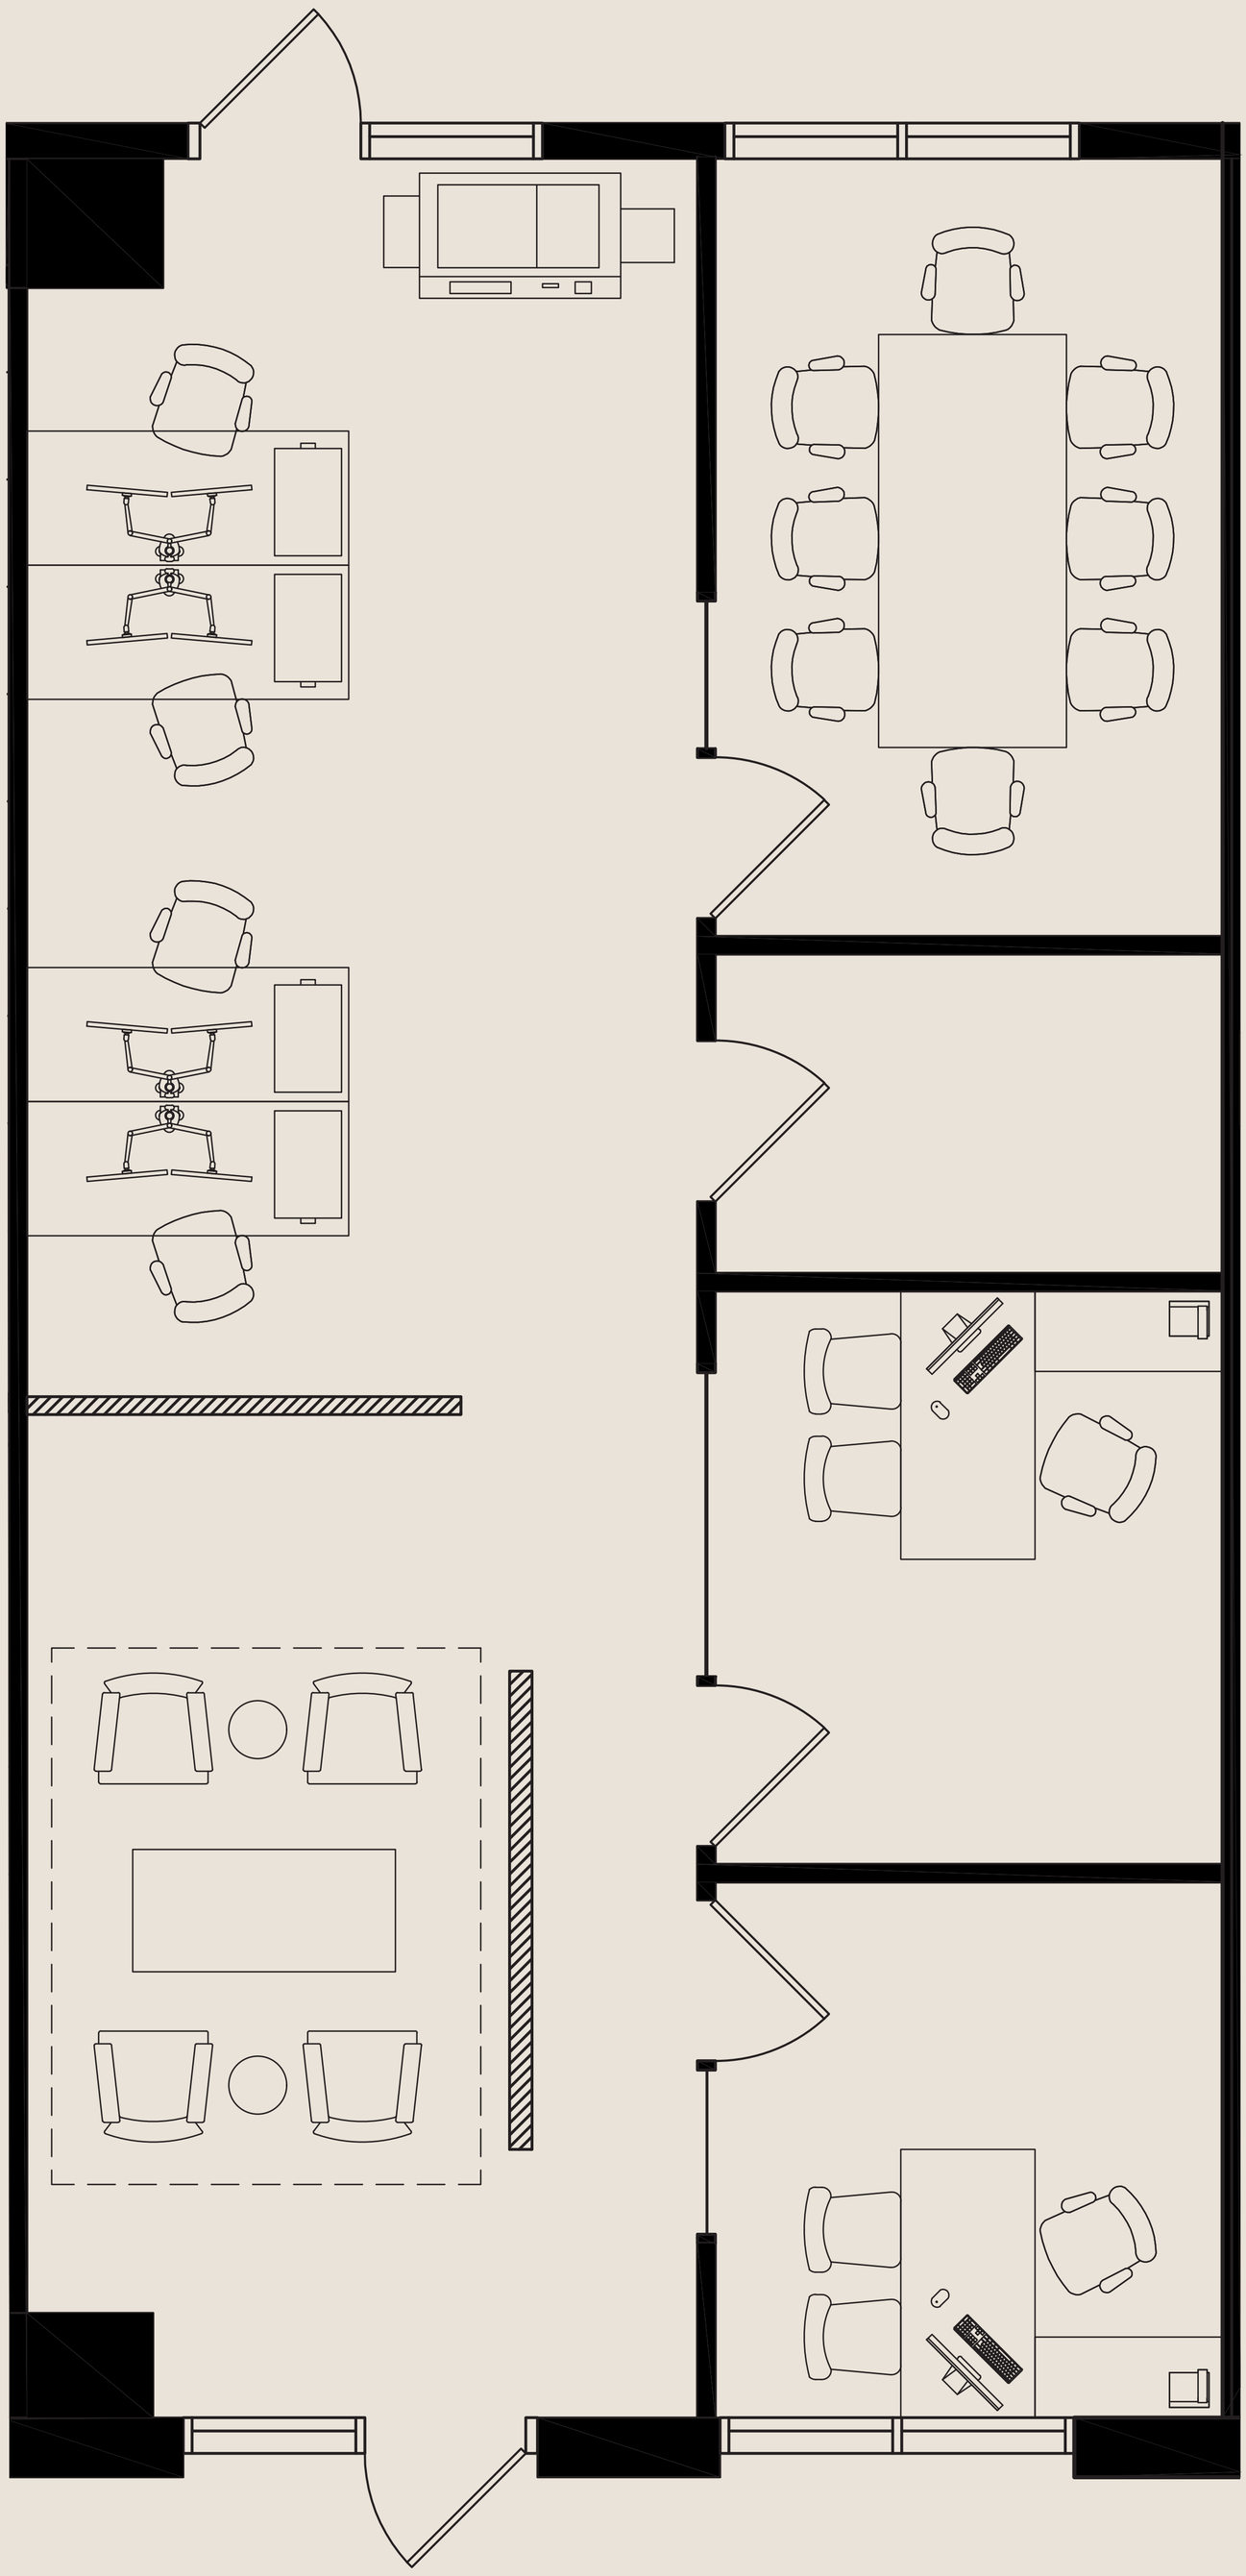

For further information, please contact:
USALEASING@ONNI.COM
(213) 629 - 2041

onni group